


T. 1 S., R. 2 W., W.M.

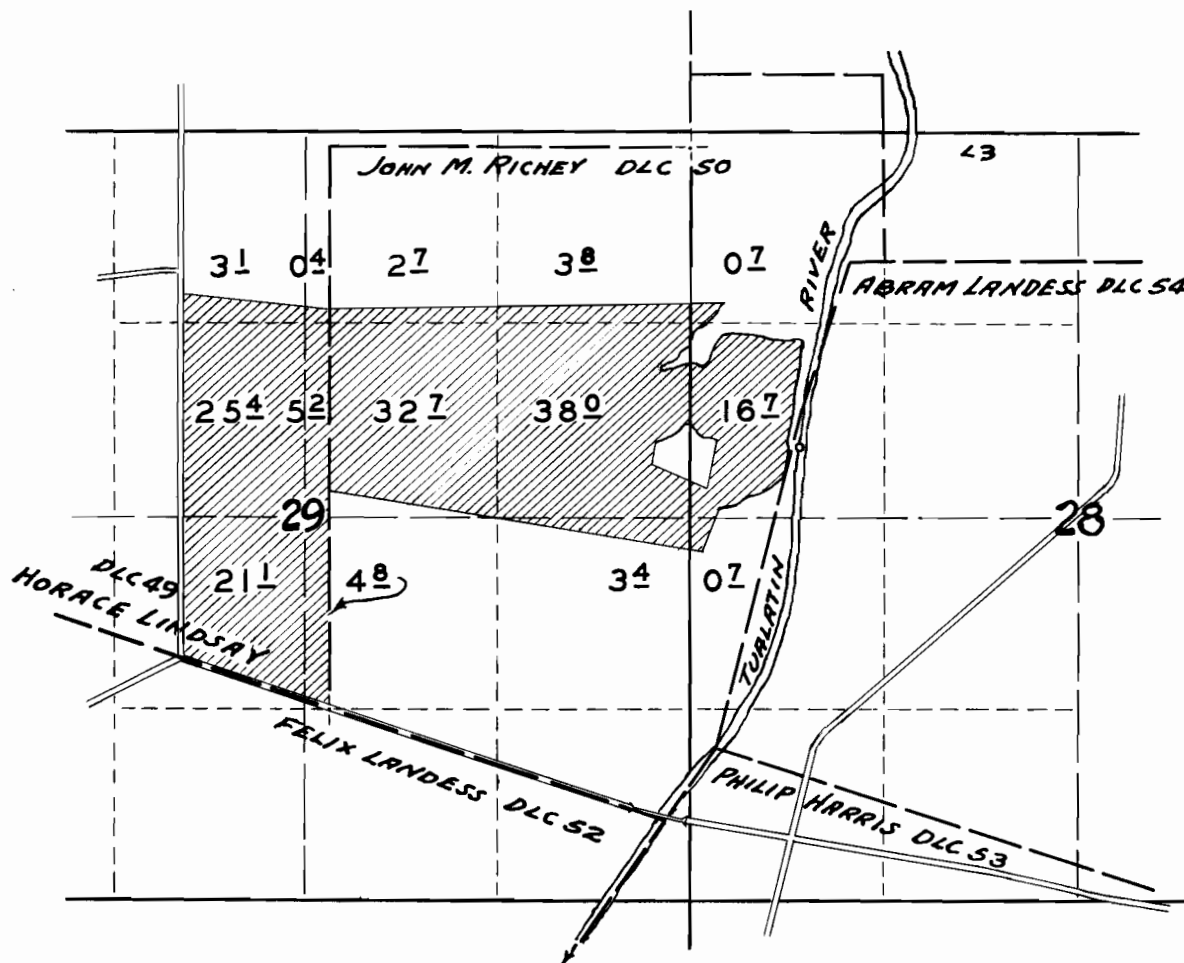

FINAL PROOF SURVEY

UNDER

Application No. 24627 Permit No. 19390

IN NAME OF

LOREN REHSE

Surveyed 4 - 25 1956, by M. BISH