


T. 4 N. R. 3 W. W. M.

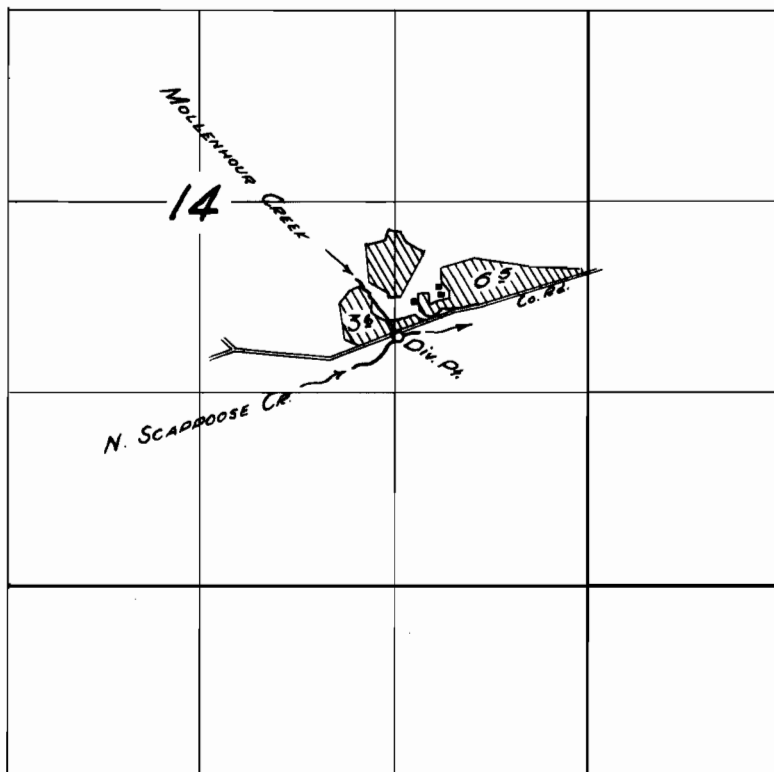

**FINAL PROOF SURVEY
UNDER**

Application No. 24678 Permit No. 19410
IN NAME OF

FRED MOLLENHOUR

Surveyed 15 July 1956, by [Signature]