


T. 4 N. R. 4 W. W. M.

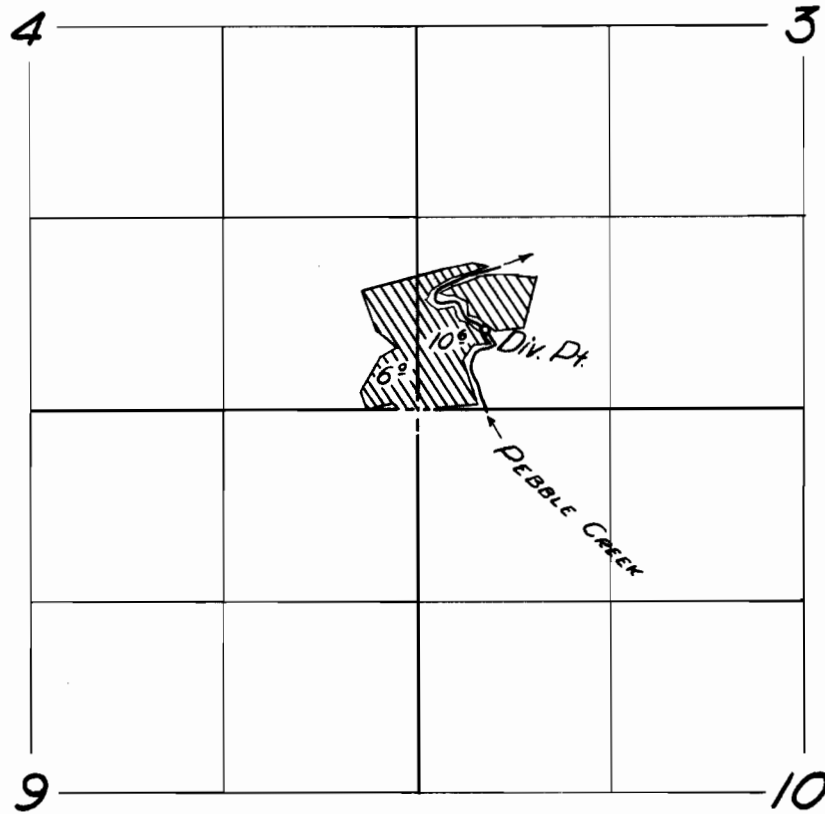

FINAL PROOF SURVEY

UNDER

Application No. 24697 Permit No. 19414

IN NAME OF

Carl Trimm

Surveyed 10 Sept. 1956, by R. H. Kelley