


T. 3S. R. 2E. W.M.

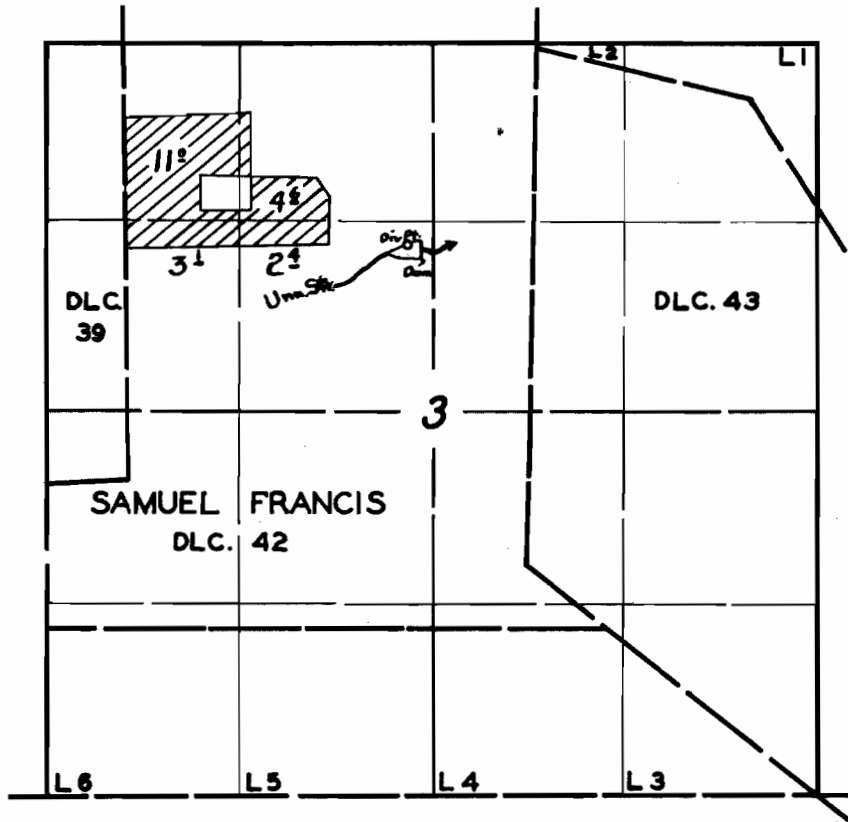

**FINAL PROOF SURVEY**

UNDER

Application No. 24674 Permit No. 19484

IN NAME OF

HERMAN A. WALDOW

Surveyed 20 June 1956, by M. Bish

DFK-10-41

TBW for Appl no 31608