


T2SR9WWM

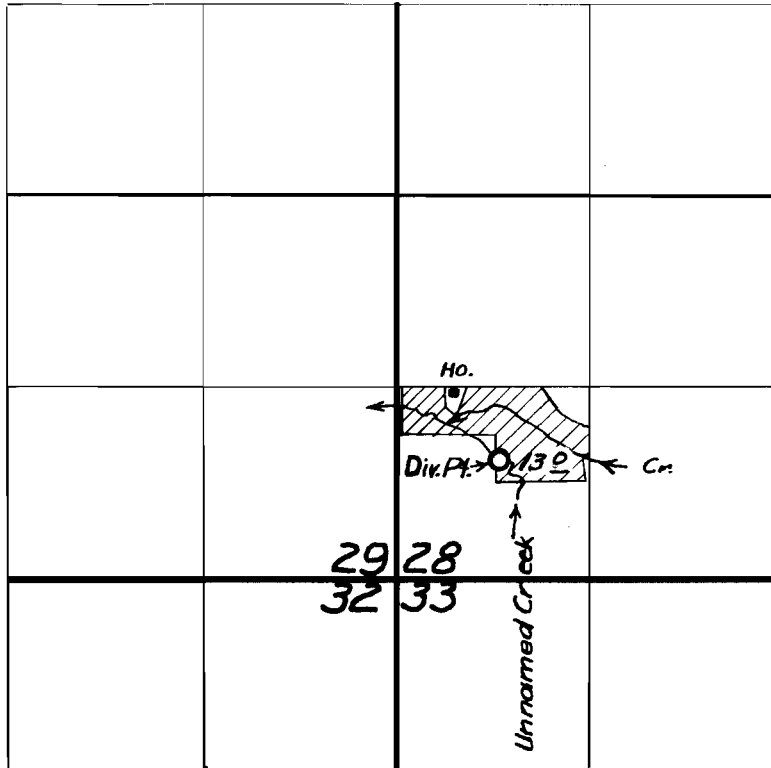

FINAL PROOF SURVEY

UNDER

Application No. **24838** Permit No. **19553**

IN NAME OF

Henry & Katherine Mueller

Surveyed *Sept. 8* 1955, by *M. Reih*

1955M