


T.10 S. R. 3 W.W.M.

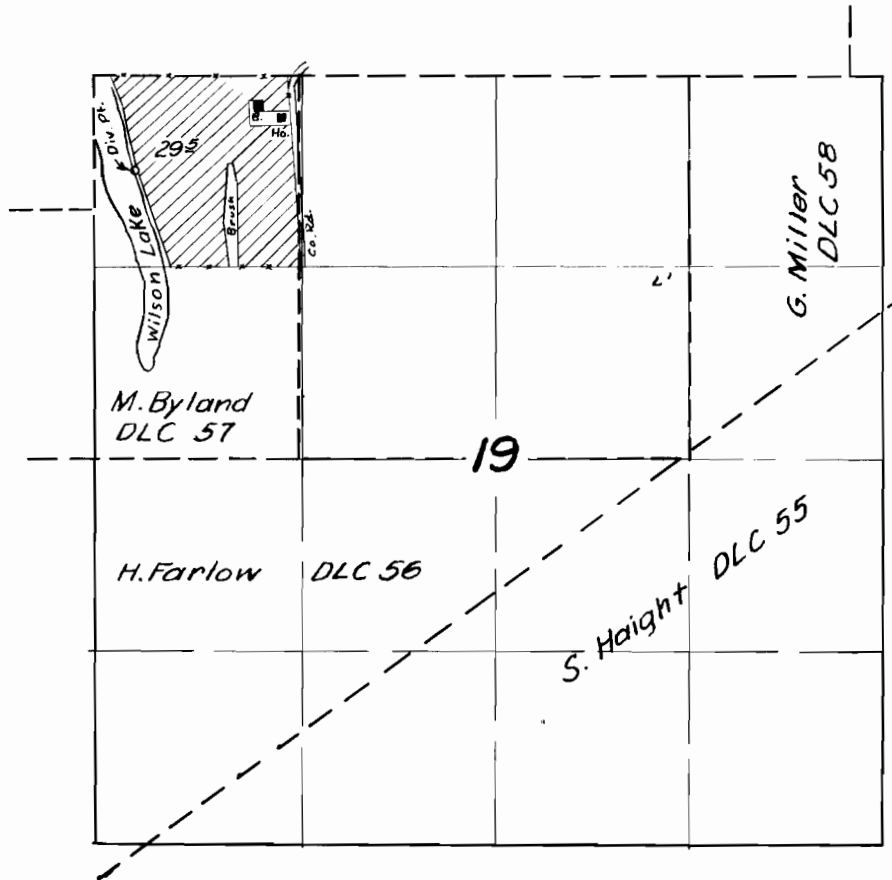

FINAL PROOF SURVEY

UNDER

Application No. 25032 Permit No. 19721....

IN NAME OF

Milton J. & Clara E. Hansen

Surveyed *Mar. 13* 1957, by *Tom Bish*