


T. 2S. R. 1 W. W.M.

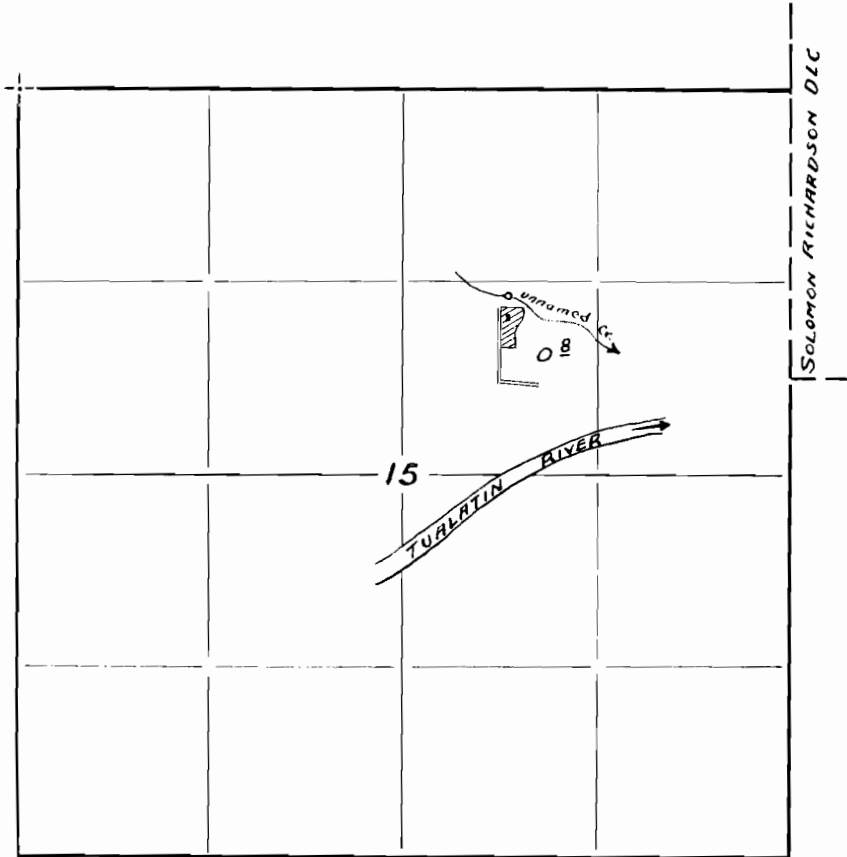

FINAL PROOF SURVEY

UNDER

Application No. 25116 Permit No. 19762
IN NAME OF

MR. & MRS. GEORGE U. BENZ

Surveyed 5 - 8 1956 by R. H. WHITBY