


T. 30 S. R. 5 W. W. M

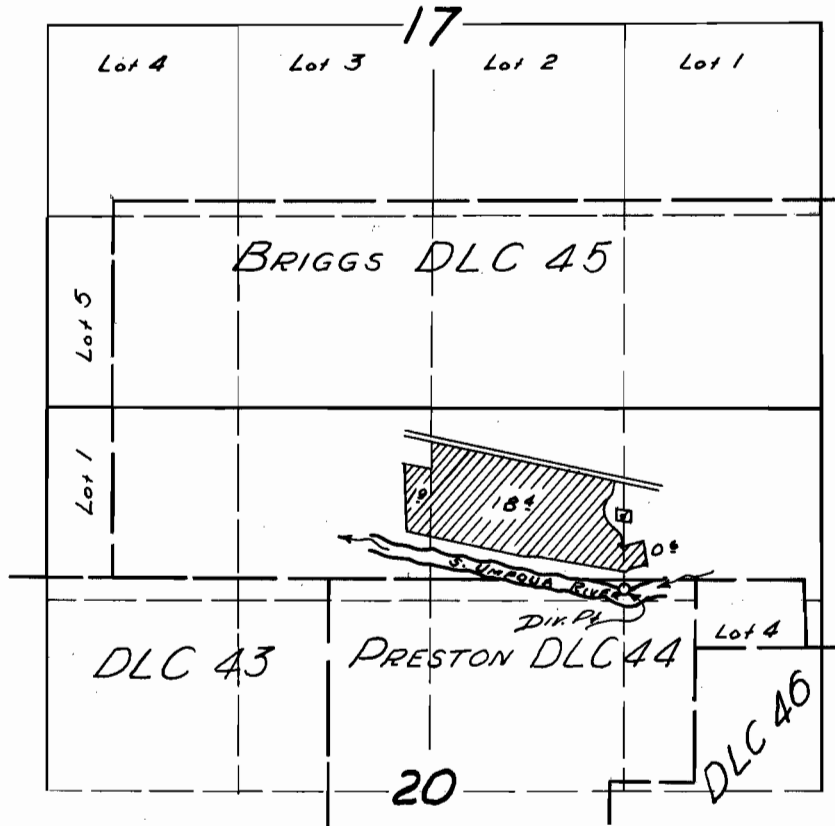

FINAL PROOF SURVEY

UNDER

Application No. 25266 Permit No. 19846

IN NAME OF

LEROY NORTHWAY

Surveyed 5 Oct. 1956, by [Signature]