


T. 3S. R. 2E. W.M.

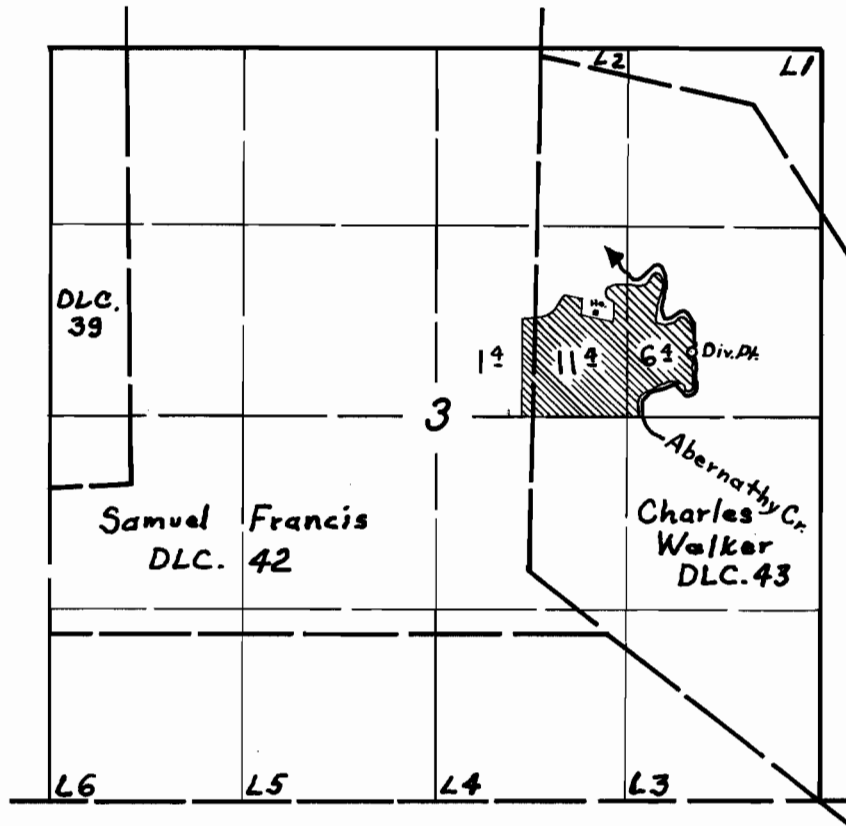

FINAL PROOF SURVEY

UNDER

Application No. 25292 Permit No. 19971

IN NAME OF

HAROLD E. & MARTHA HORTON

Surveyed 20 June 1956, by M. Bish

DFK-1D-41

2075