


T. 9 S. R. 1 W. W. M.

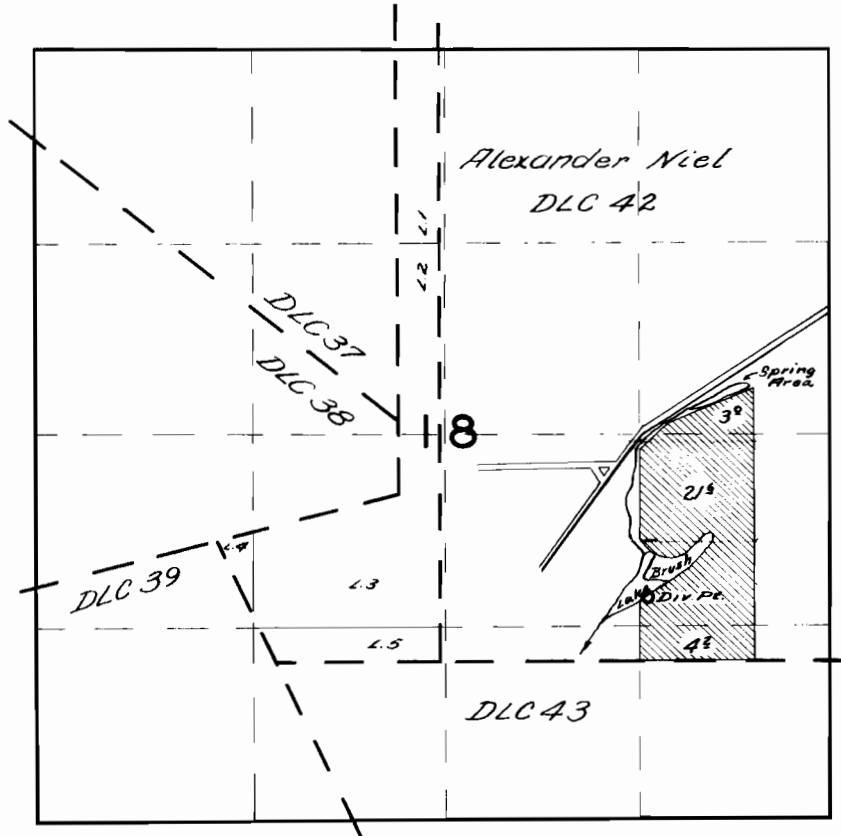

FINAL PROOF SURVEY

UNDER

Application No. 25480 Permit No. 20027.

IN NAME OF

Leo F. Odenthal

Surveyed *May 16 1956*, by *R.H. Whitby*

DFN-2D-185