


T. 1 N. R. 3 W. W.M.

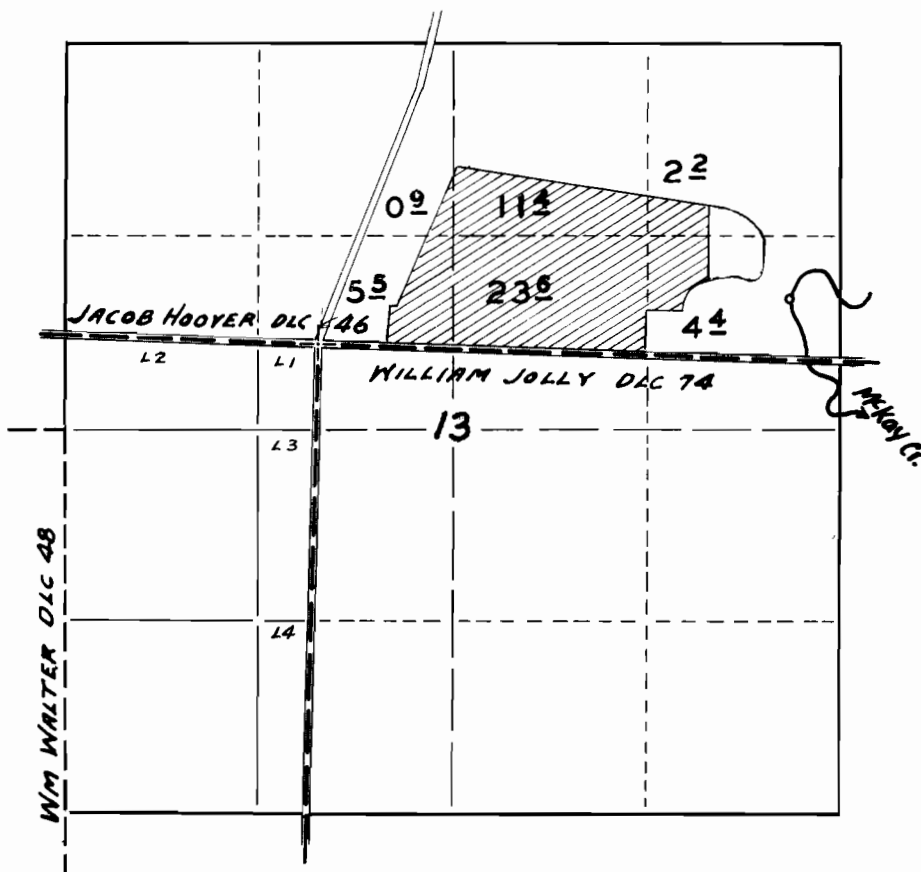

FINAL PROOF SURVEY

UNDER

Application No. 25546 Permit No. 20059

IN NAME OF

EDWIN SIMANTEL

Surveyed 4-26 19 , by R.H. WHITBY