


15			14			13			
22			23			24			
27			26			25			
34			35			36			

FROM OFFICE OF THE STATE ENGINEER, SALEM, OREGON

Willow Creek Adjudication.

35.28 E.

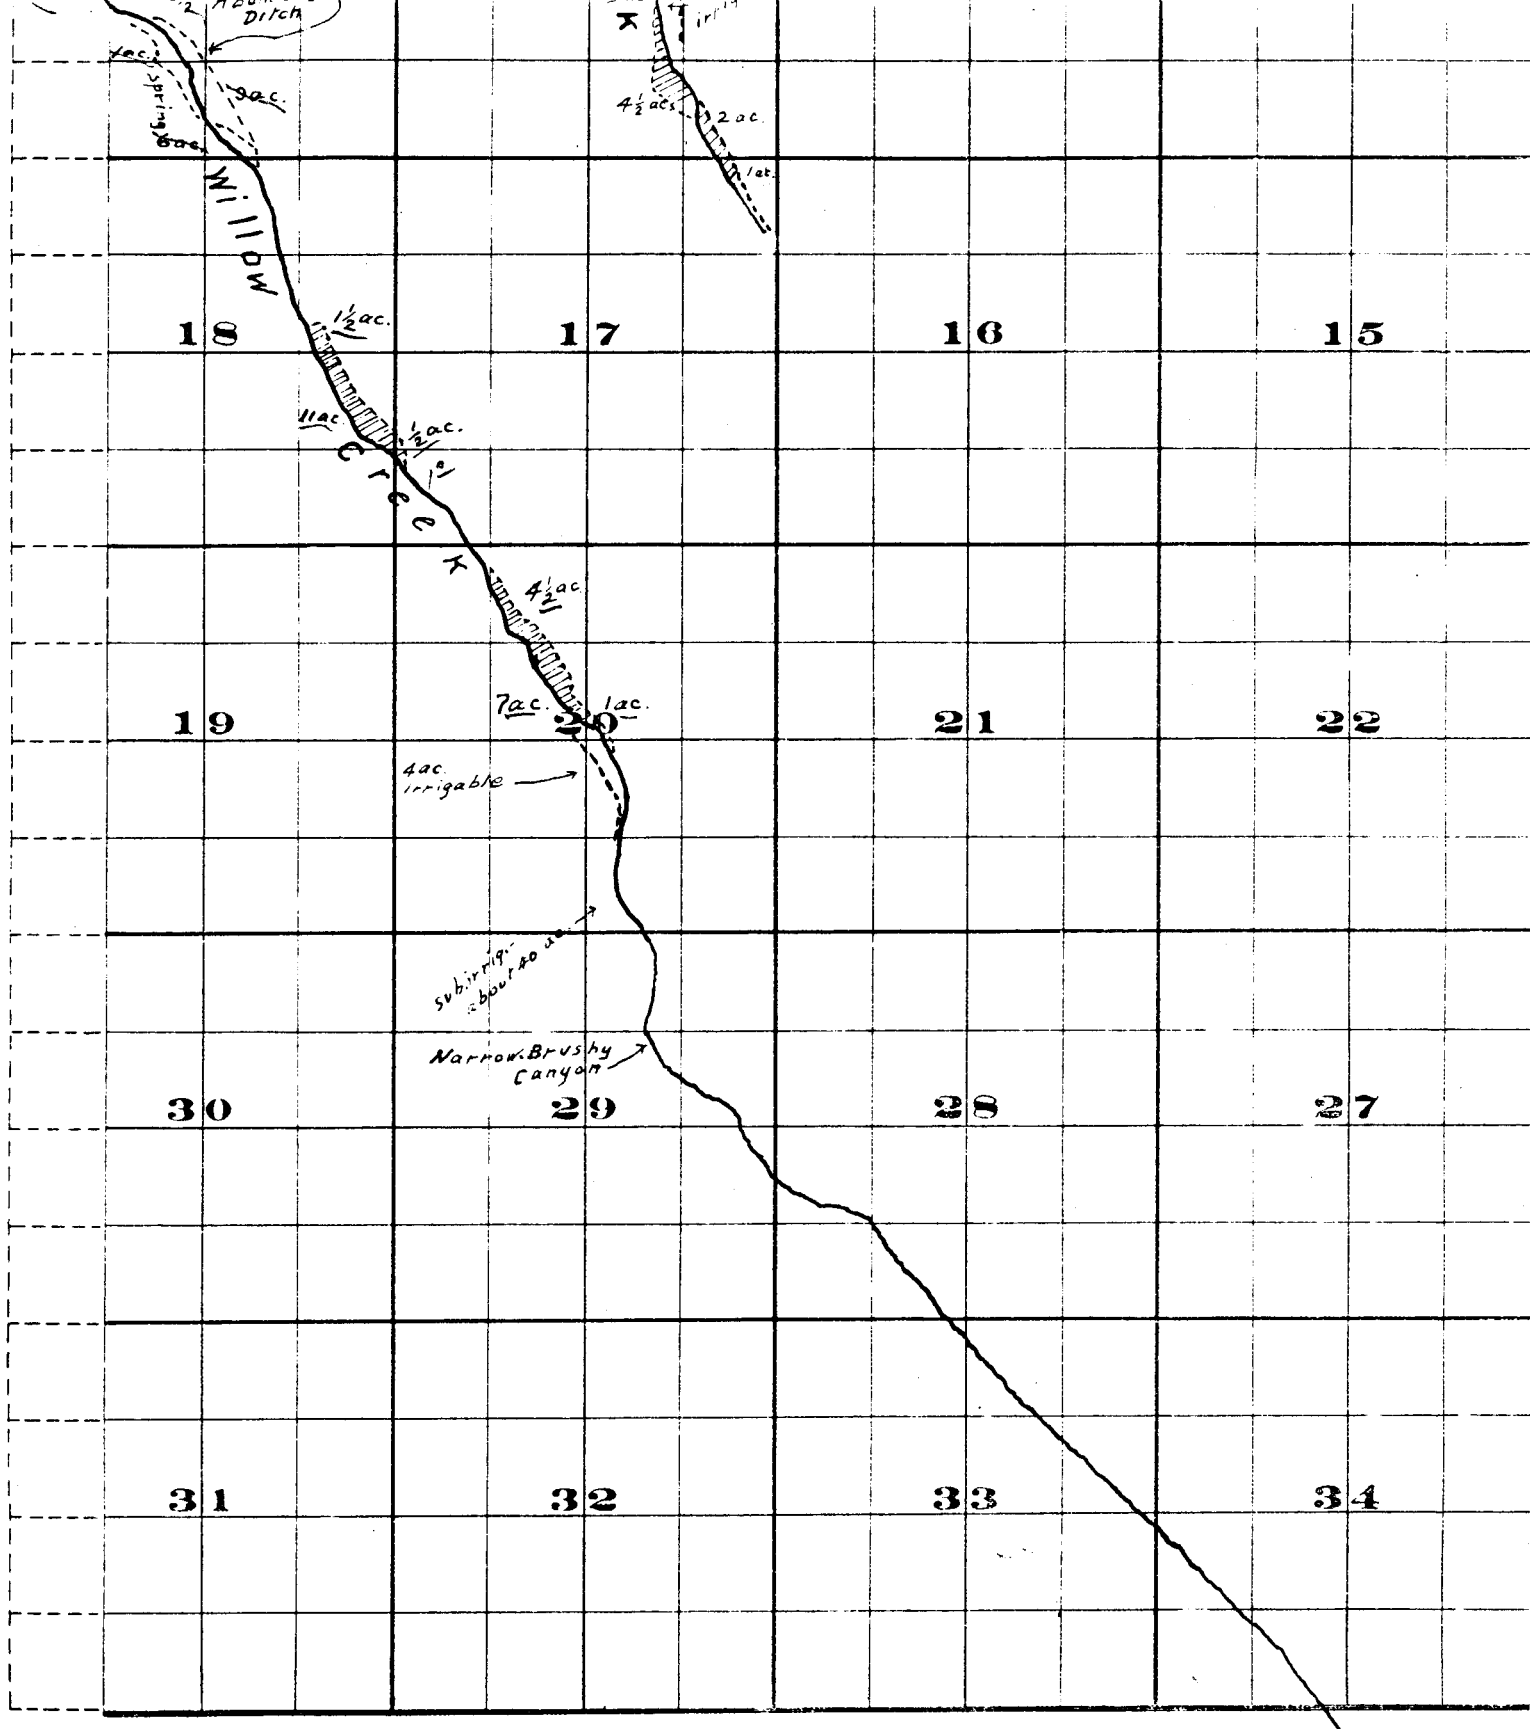

THIS IS A BRISTOL CO. PRINTERS & BOUNDERS. NEW YORK, N.Y.


Hinton Creek Surveyed by H.K. Donnelly July 1909

Willow Creek Surveyed by R.D. Cooper July 1909

John H. Lewis - State Eng'r.

Examined July 14, 1909.

Township 3. S. ,

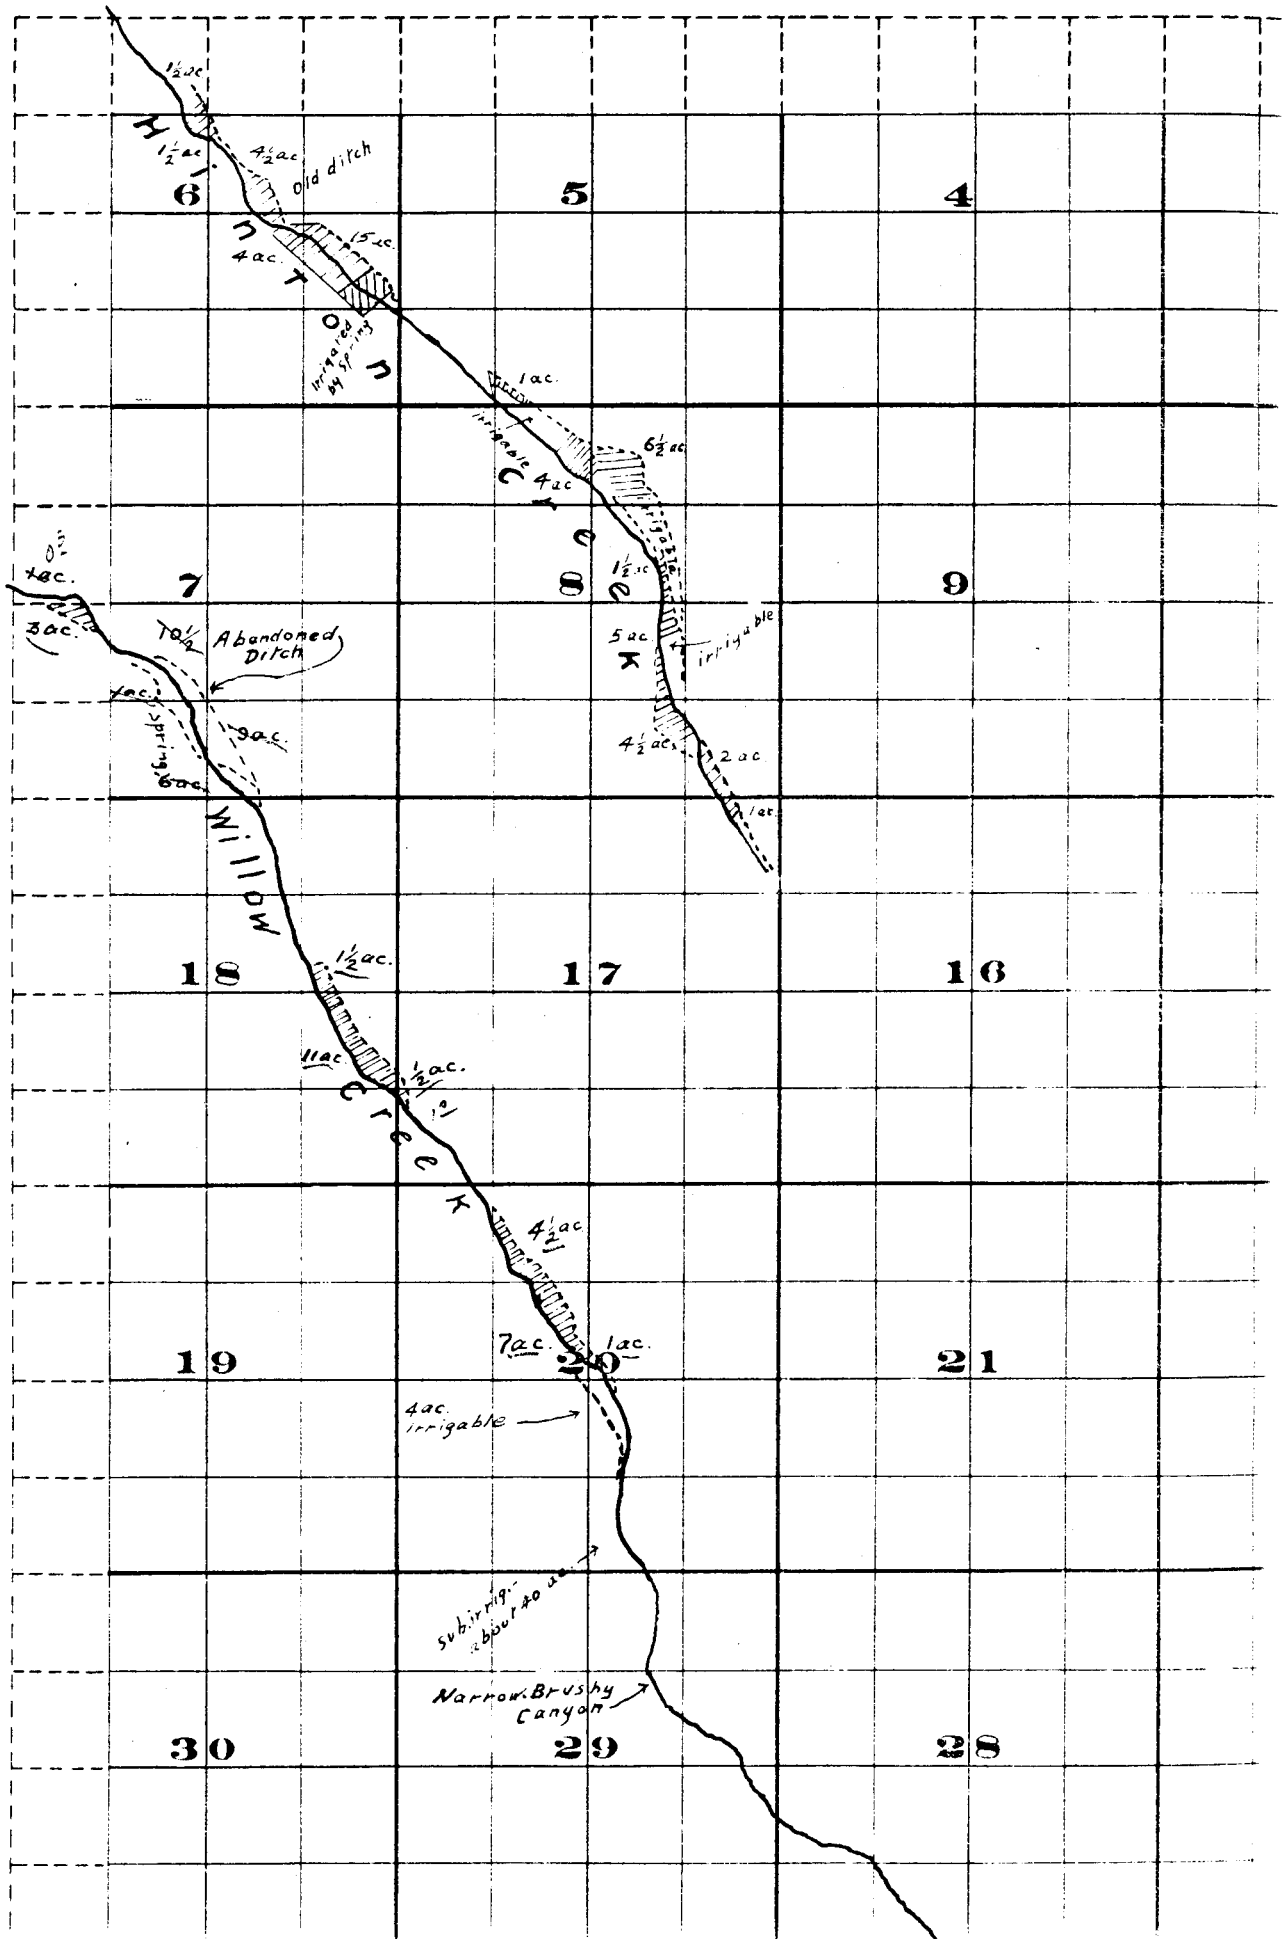

[illegible]