
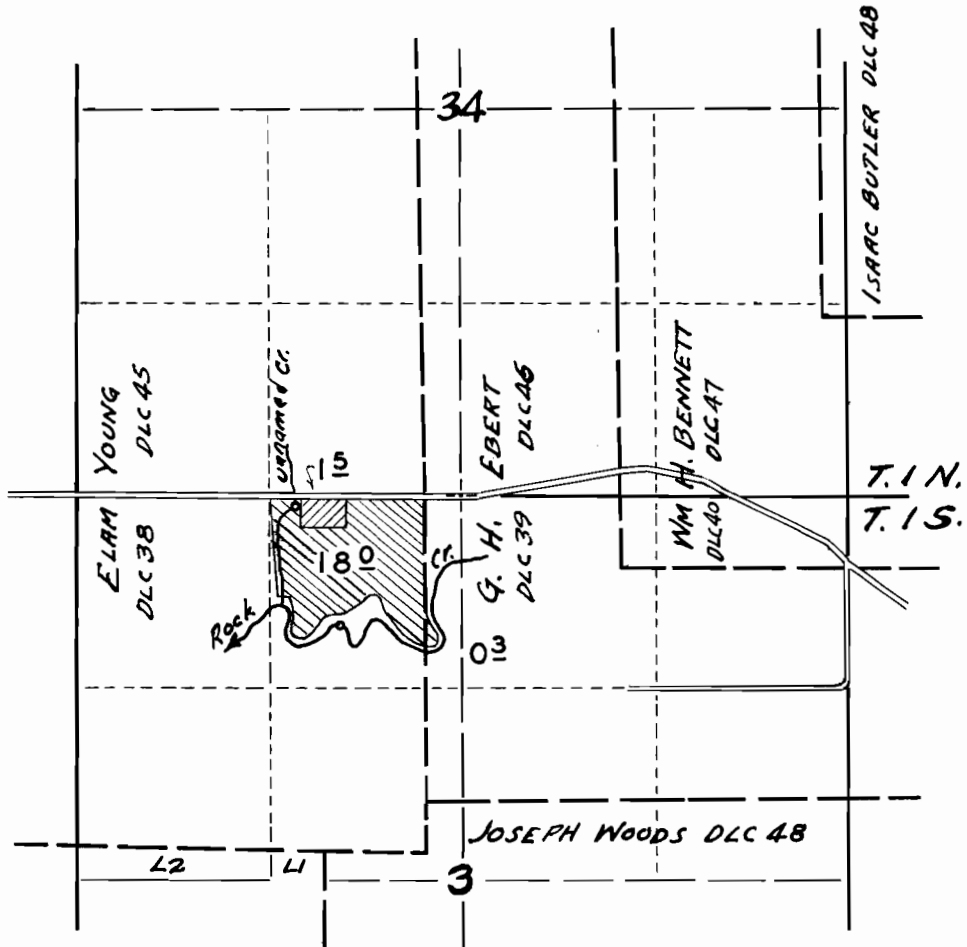



T.1N. & T.1S., R.2W., W.M.

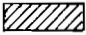

From unnamed creek 
From Rock creek 

FINAL PROOF SURVEY

UNDER

Application No. 26977 Permit No. 21190

IN NAME OF

C. B. HENDERSON

Surveyed 4 - 17 1956, by M. BISH