


T. IN. R. 3 E. W. M.

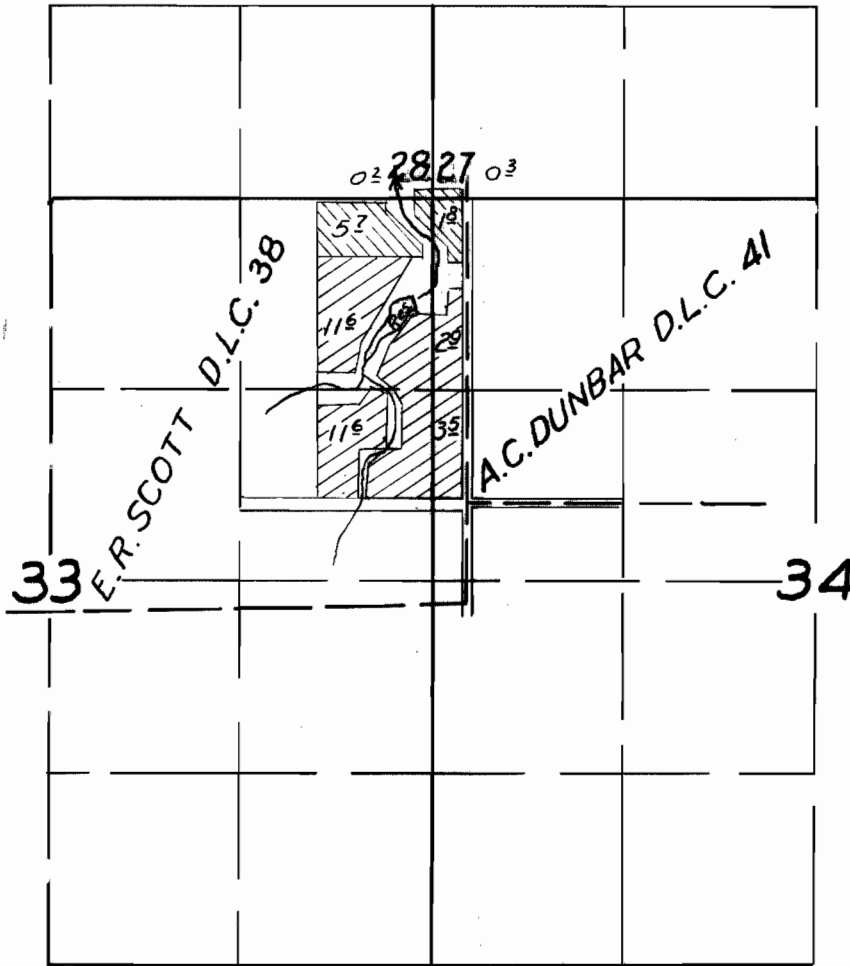

FINAL PROOF SURVEY

UNDER

Application No. *R-25632* *25633* *26674* Permit No. *R-1149* *20231* *20887*

IN NAME OF

C. H. STONE

Surveyed *24 July 1956*, by *Tom Bish*