

NW¼ of SE¼ of SEC. 26, T-2-N, R-10-E, W.M.

STADELMAN FRUIT  
STORAGE  
BLDG.

WELL

350'


574'

SURVEYED BY - *M. Puhner* DATE - Jan. 15, 1954

SCALE - 1" = 200'

U-662

RECEIVED  
FEB 2 1954  
STATE ENGINEER  

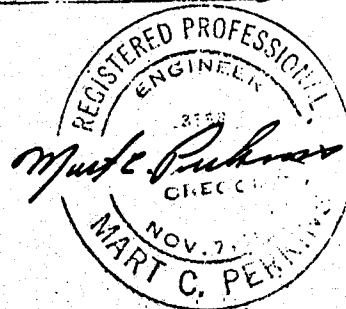

U-662

U-604