


T.2S., R.1E., W.M.

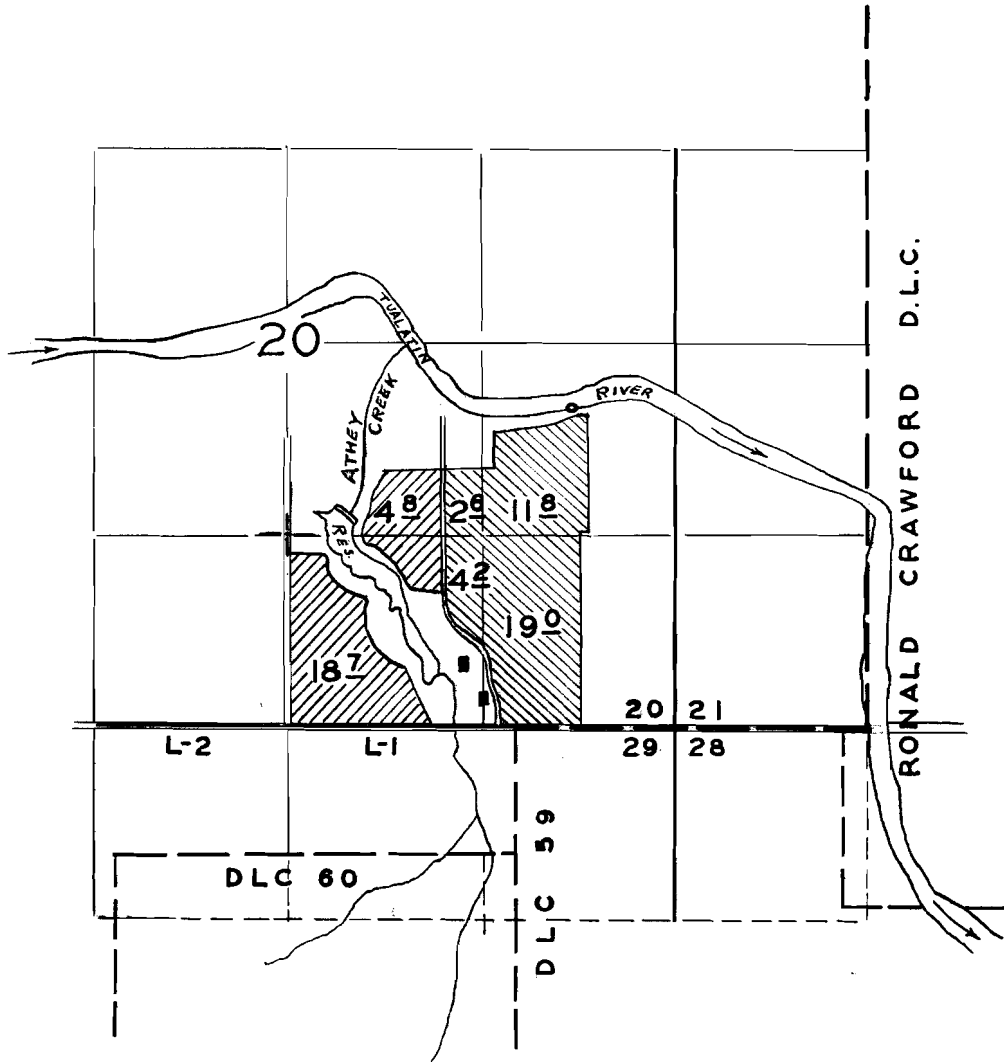

FINAL PROOF SURVEY

UNDER

R-28080

R-1421

Application No. 2700.5 Permit No. 2166.5

IN NAME OF

SCHABER BROTHERS

Surveyed 5-9 1956 by R.D. BEST.

////// FROM RESERVOIR

||||| FROM TUALATIN RIVER