


T.3N. R.3 W. W.M.

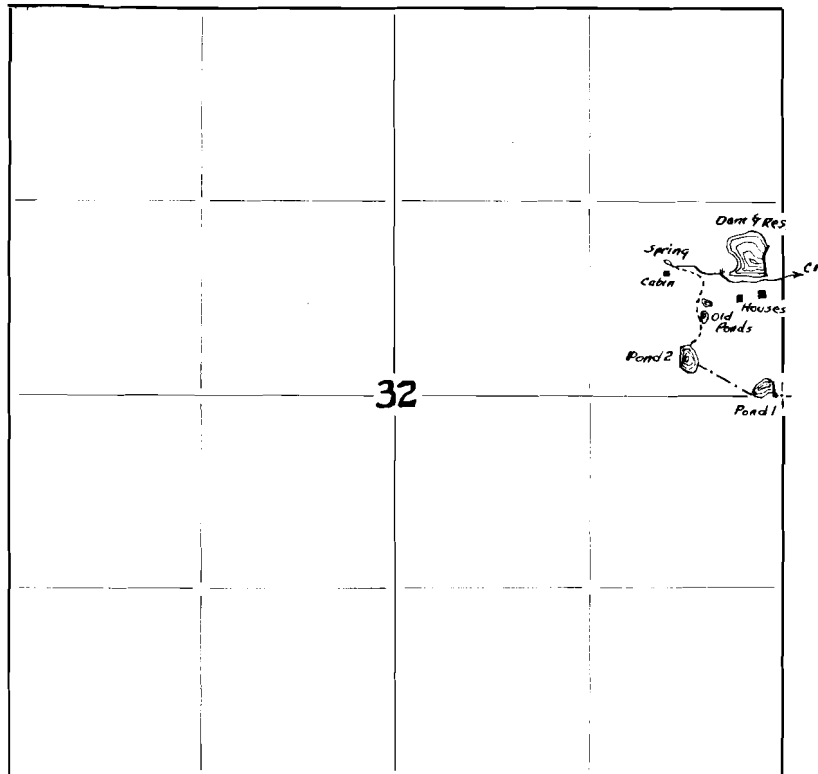

FINAL PROOF SURVEY

UNDER

Application No. ^{R-30725} 30726 Permit No. ^{R-1866} 24290

IN NAME OF

J. H. DIETRICH

Surveyed 4 - 10 1956 by R. H. WHITBY