
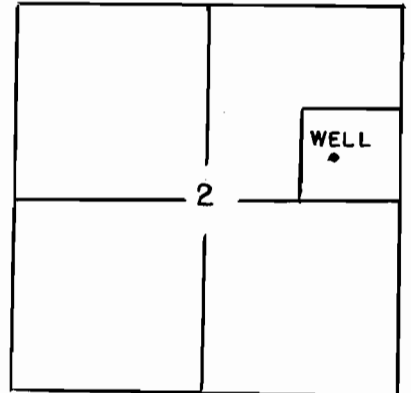


E-W \odot SEC. 2
T. 5 N. R. 35 E. W.M.

1
2
1/4 CORNER.

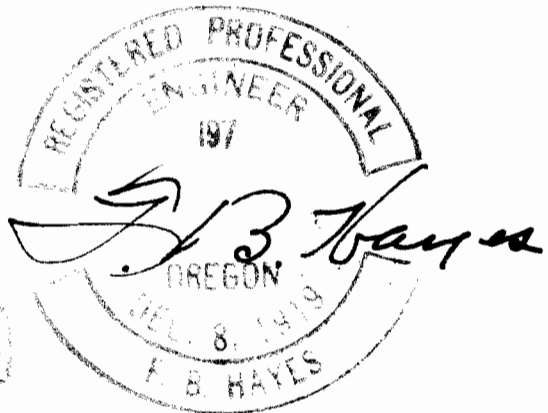

VICINITY MAP.

LOCATION WELL No. 4
MILTON - FREEWATER OREGON.
SCALE 1" = 100'
JUNE 1952

Application No. U-808
Permit No. U-717

RECEIVED
STATE ENGINEER
MILTON, OREGON

U-508