


T. 5 N. R. 35 E. W. M.
VICINITY MAP.

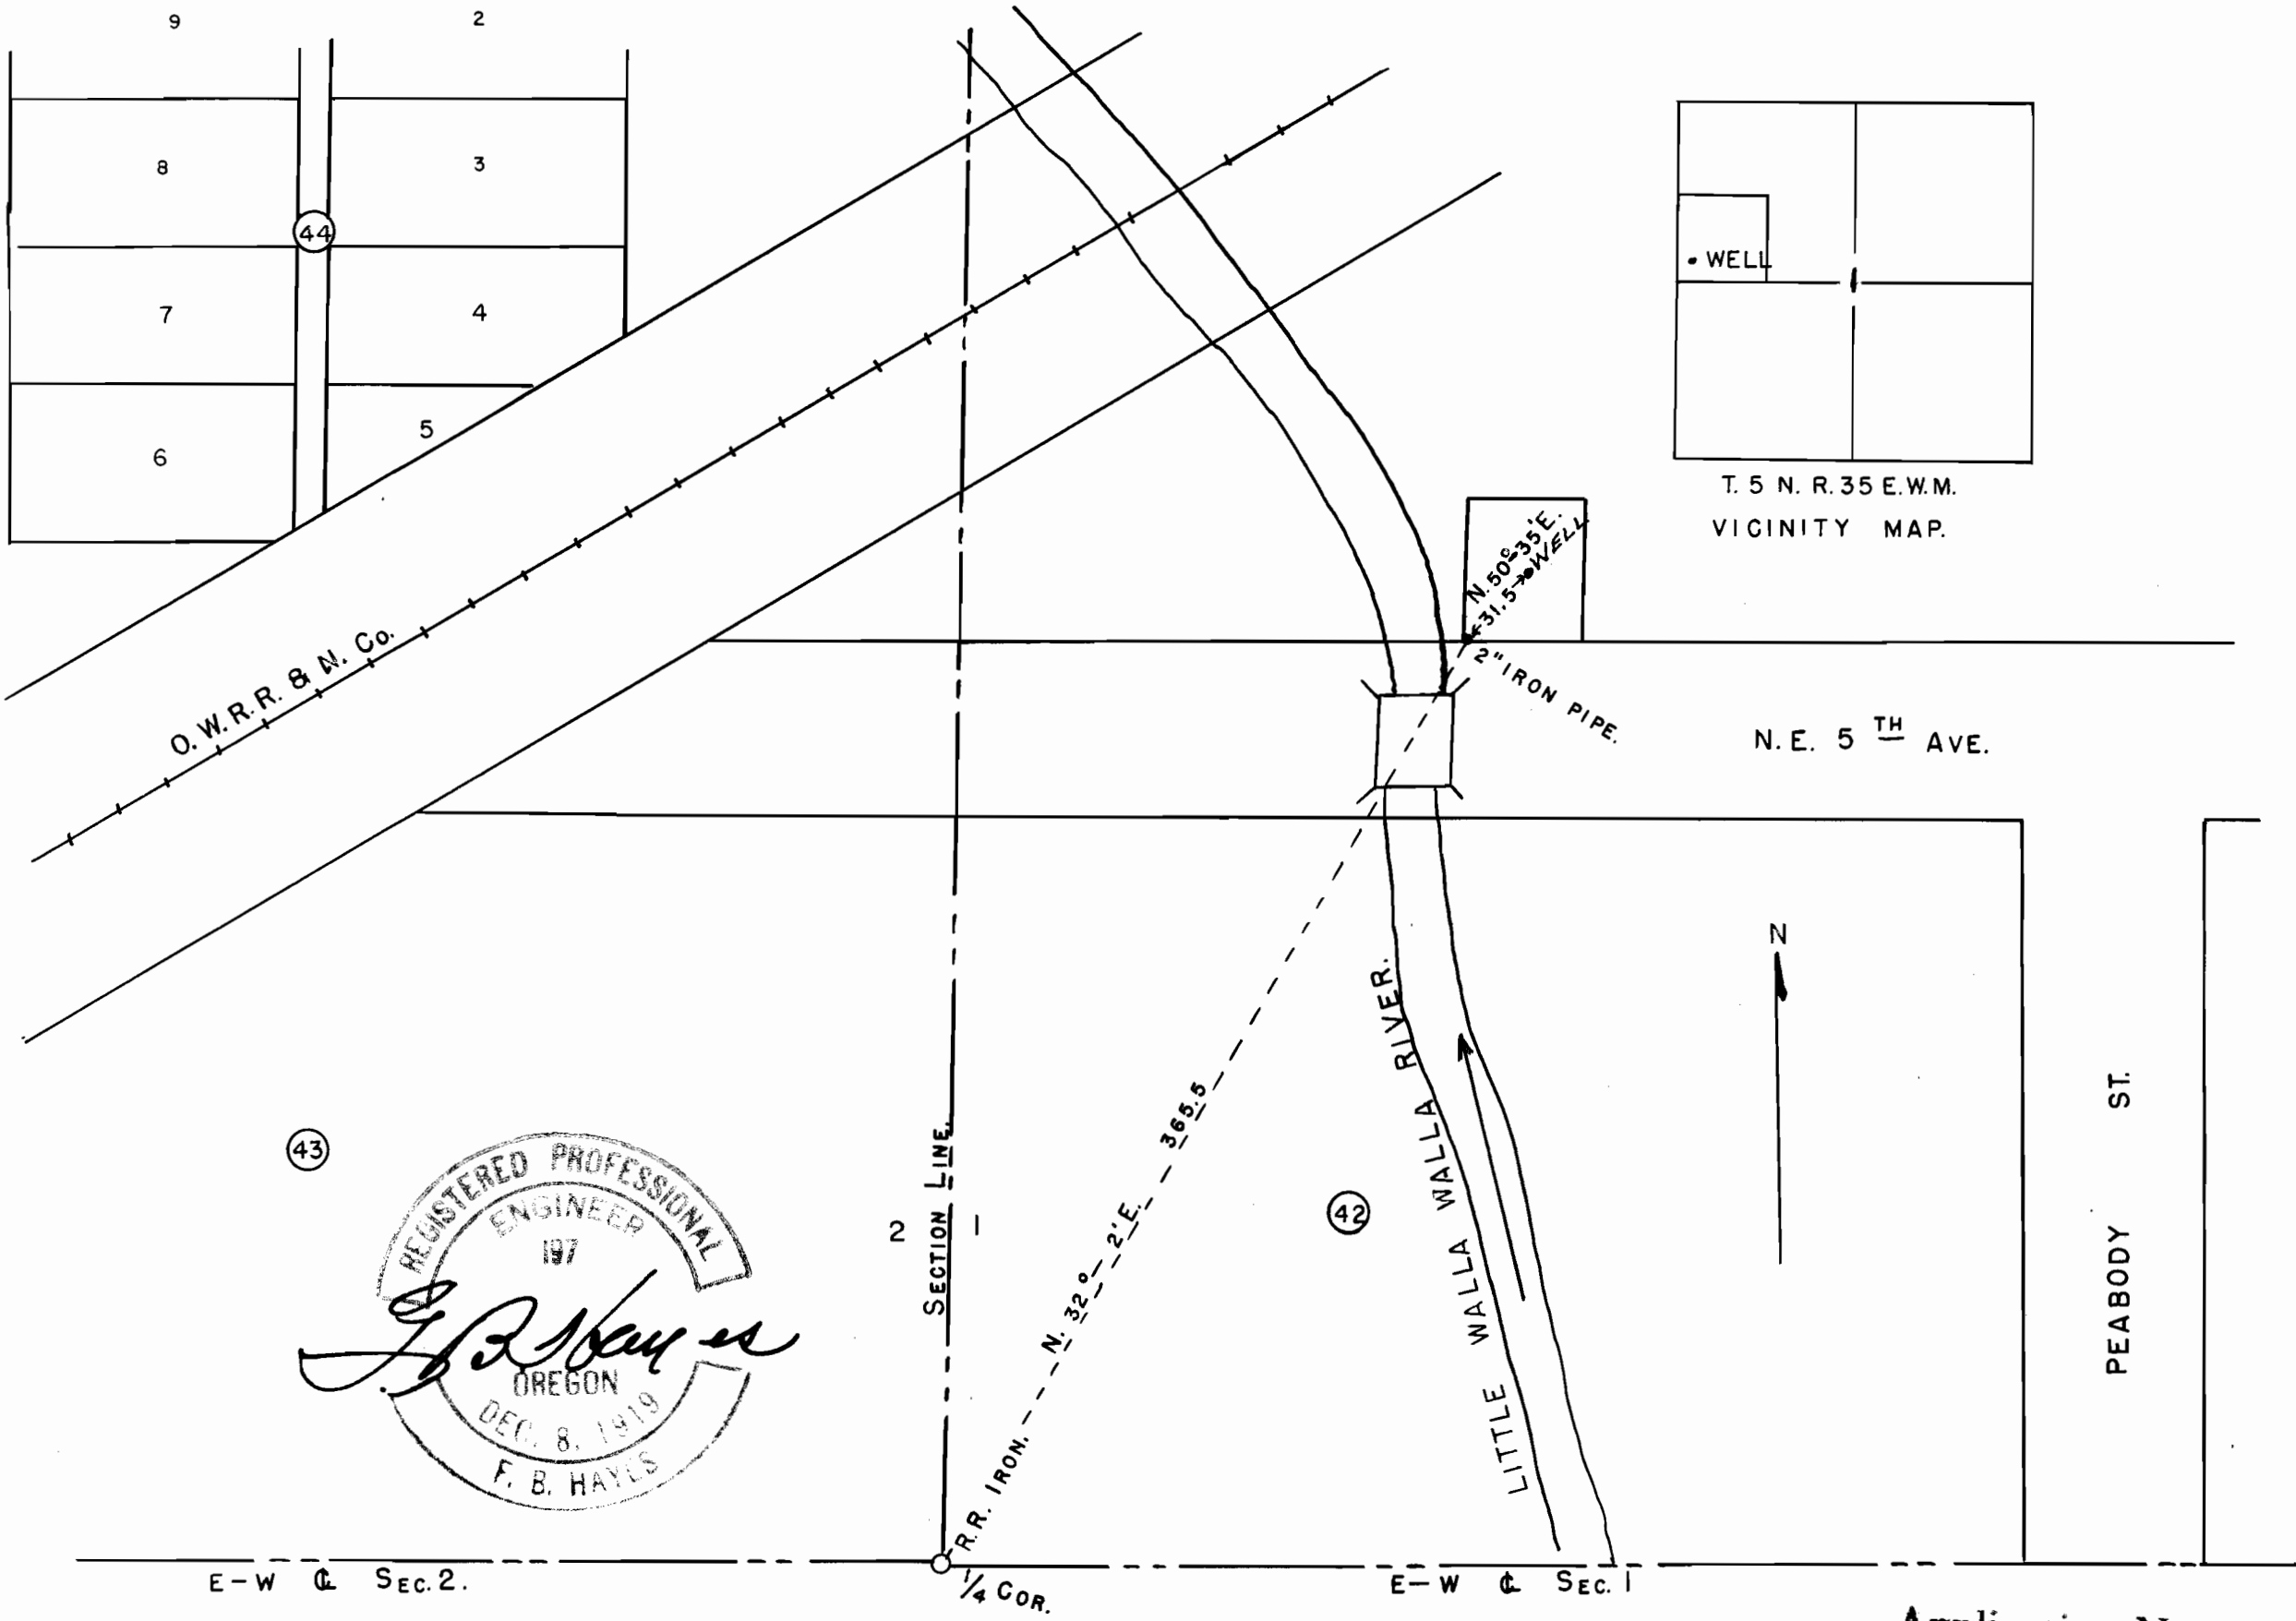

(43)
 REGISTERED PROFESSIONAL
 ENGINEER
 197
F. B. Hayes
 OREGON
 DEC. 8, 1919
 F. B. HAYES

E-W & SEC. 2.

SECTION LINE

1/4 COR.

(42)

E-W & SEC. 1

RECEIVED
 APR 18 1952
 STATE ENGINEER
 OREGON

LOCATION WELL No. 5
 MILTON-FREEWATER, OREGON.
 SCALE 1" = 60'

Application No. U-809
 Permit No. U-718

JUNE 1952

PEABODY ST.

U-809