


WELL #1 IS LOCATED 431' NORTH AND 550' WEST OF SOUTH EAST CORNER OF THE OCTAVE MARTEL D.L.C.

WELL #2 TO BE LOCATED 588' NORTH AND 930' WEST OF SOUTH EAST CORNER OF THE OCTAVE MARTEL D.L.C.

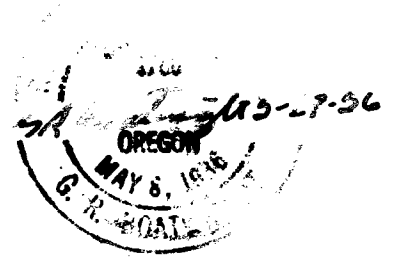

WATER RIGHT MAP
 FOR BETHEL GOSPEL PARK
 SHOWING LOCATION OF WELLS
 G.R. BOATWRIGHT ENGINEER
 SCALE 1"=200' MAY 29, 1956

Application No. G-383
 Permit No. G-258