


T.10 S. R. 3 W. W. M.

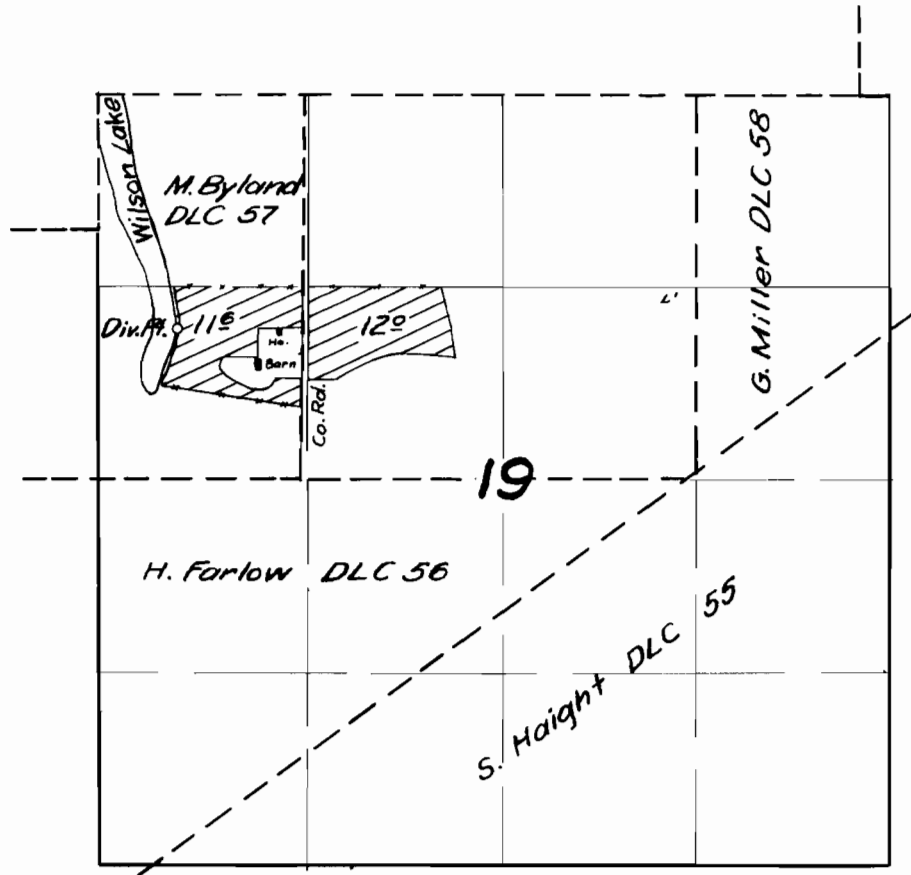

FINAL PROOF SURVEY

UNDER

Application No. 24892... Permit No. 19579...

IN NAME OF

Ivan Torney or Veda Torney

Surveyed *Mar. 13*, 1957, by *Tom Bisher*