


T. 30 S. R. 4 W. W.M.

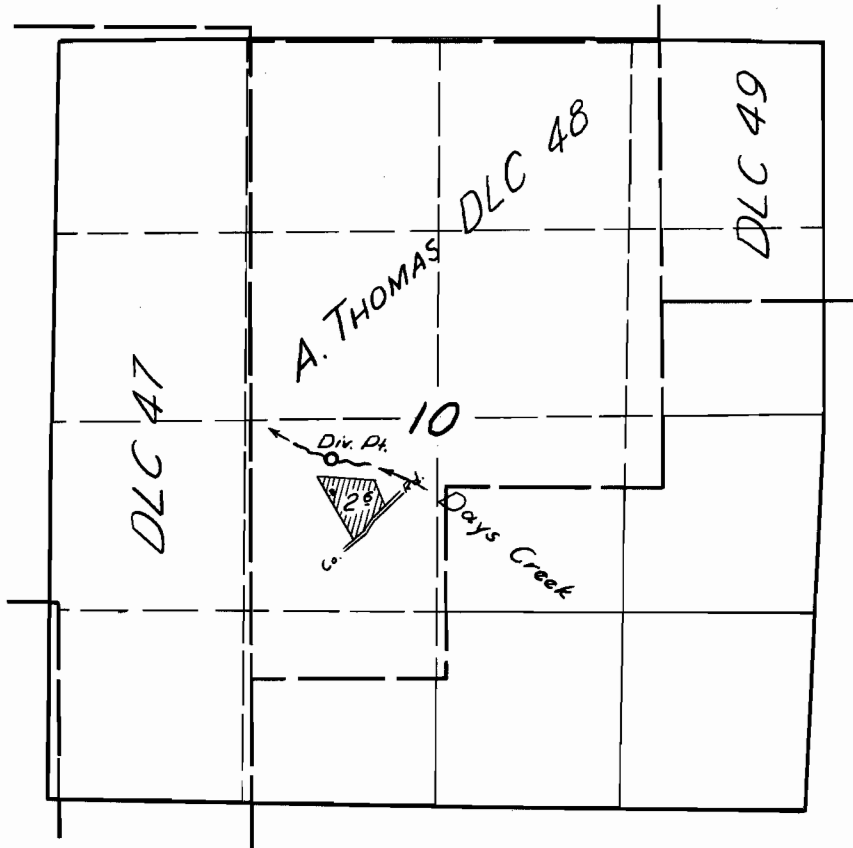

FINAL PROOF SURVEY

UNDER

Application No. 25192 Permit No. 19807

IN NAME OF

D. H. MERRITT

Surveyed 18 Oct 1956, by *R. W. Kelly*