
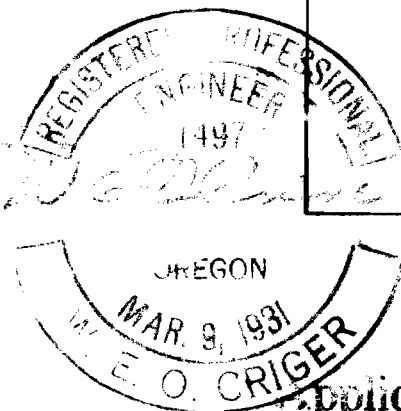
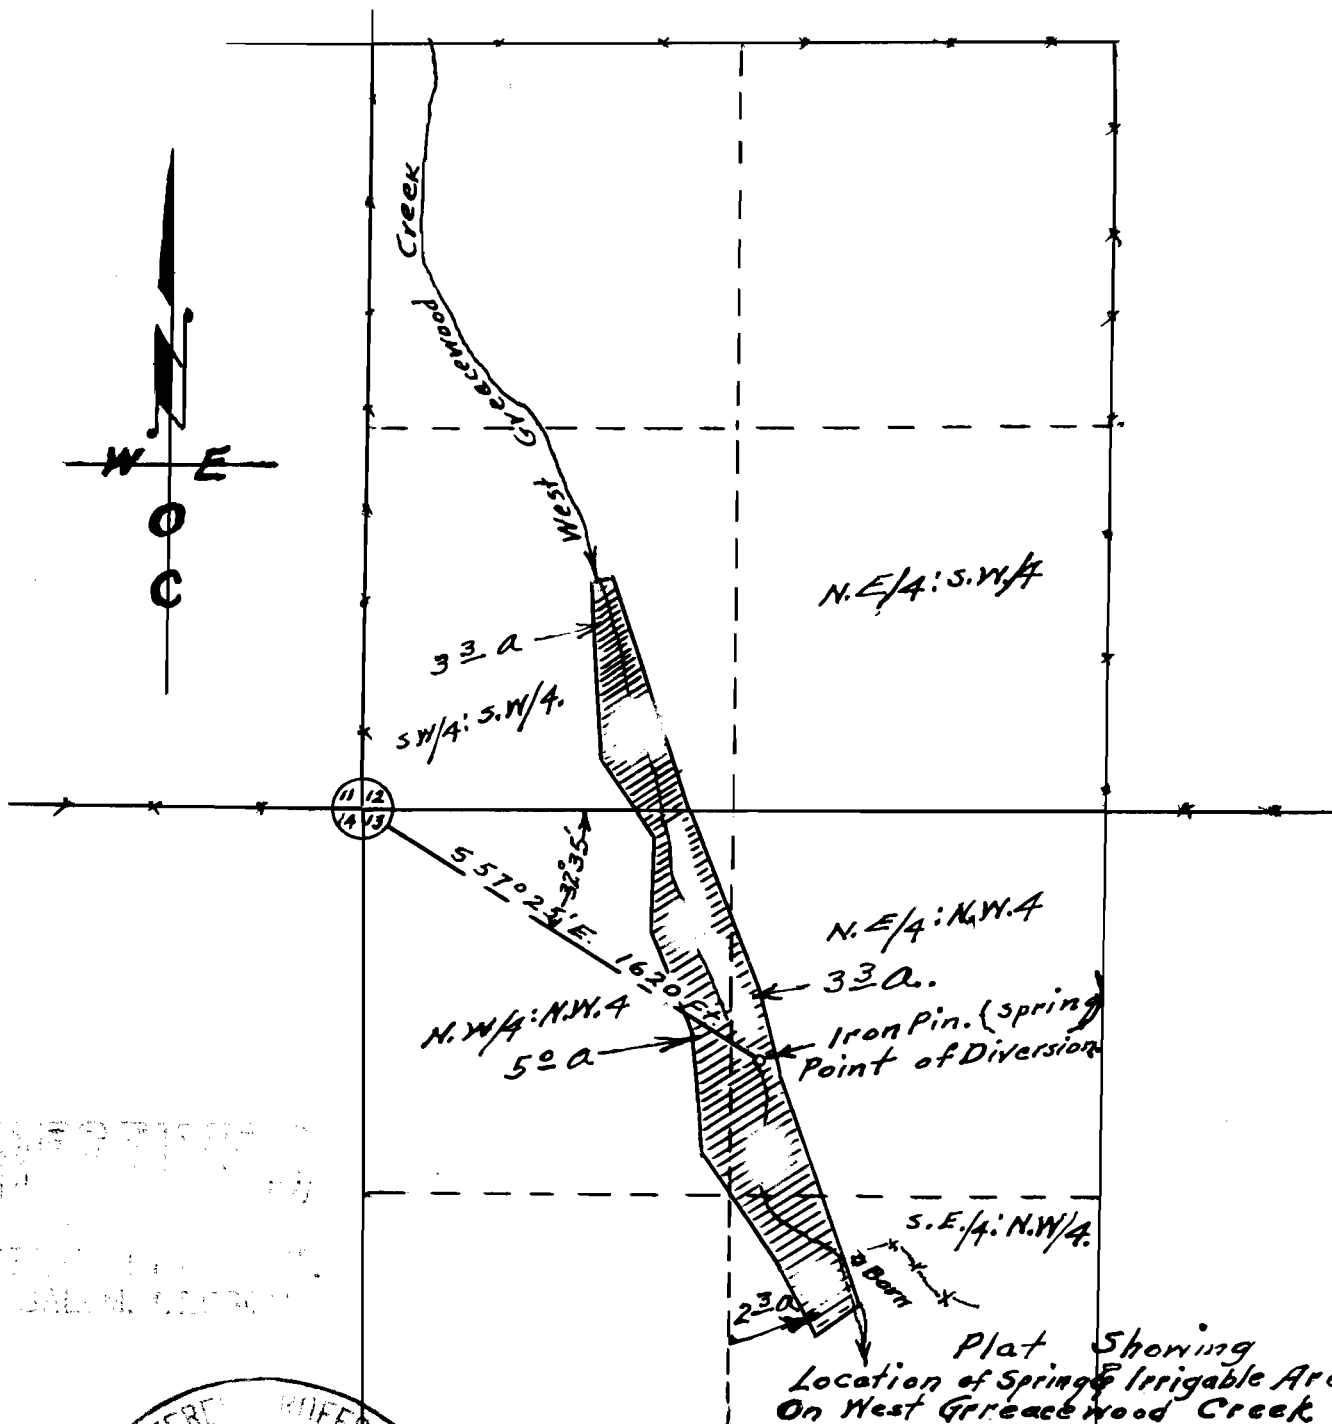


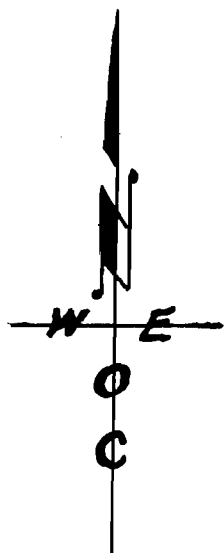

Plat Showing
Location of Spring & Irrigable Area
On West Greasewood Creek

In S.W. 1/4 Sec. 12 and N.W. 1/4 Sec. 13 T.3N. R.33 E. M. of Oregon
surveyed & platted July 1950 By W.E.O. Criger
Scale: 1 inch = 660 Feet.

I, W.E.O. Criger of Pendleton, Oregon,
do hereby certify that this map was
made from notes taken during an actual
survey made by me on July 17, 1950,
that the monument shown on this map
consisting of a 7/8" x 3/8" Iron pin is S. 57° 25' E
a distance of 1620 ft from the N.W. Corner
of Sec. 13, T.3N., R.33 E. M. of Oregon.

Application No. 25257

Permit No. 19842

W.E.O. Criger.