


T. 7 S. R. 3 E. 4 W. W.M.

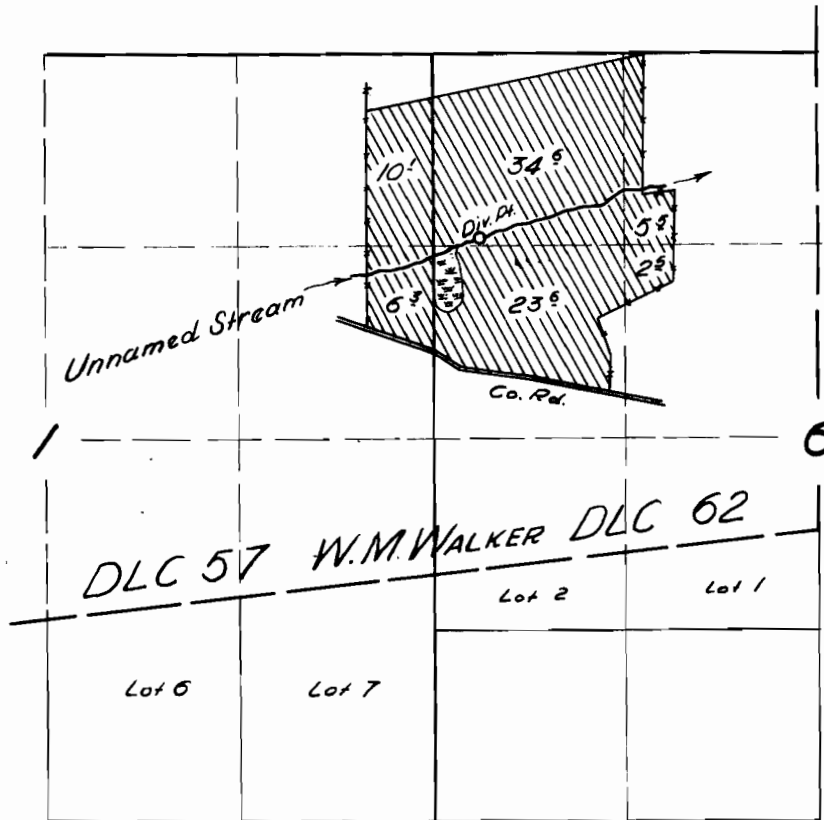

FINAL PROOF SURVEY

UNDER

Application No. 24947 Permit No. 19692

IN NAME OF

K. W. NOTEBOOM

Surveyed 13 Mar. 1957, by [Signature]