


T.2 N., R.4 W., W.M.

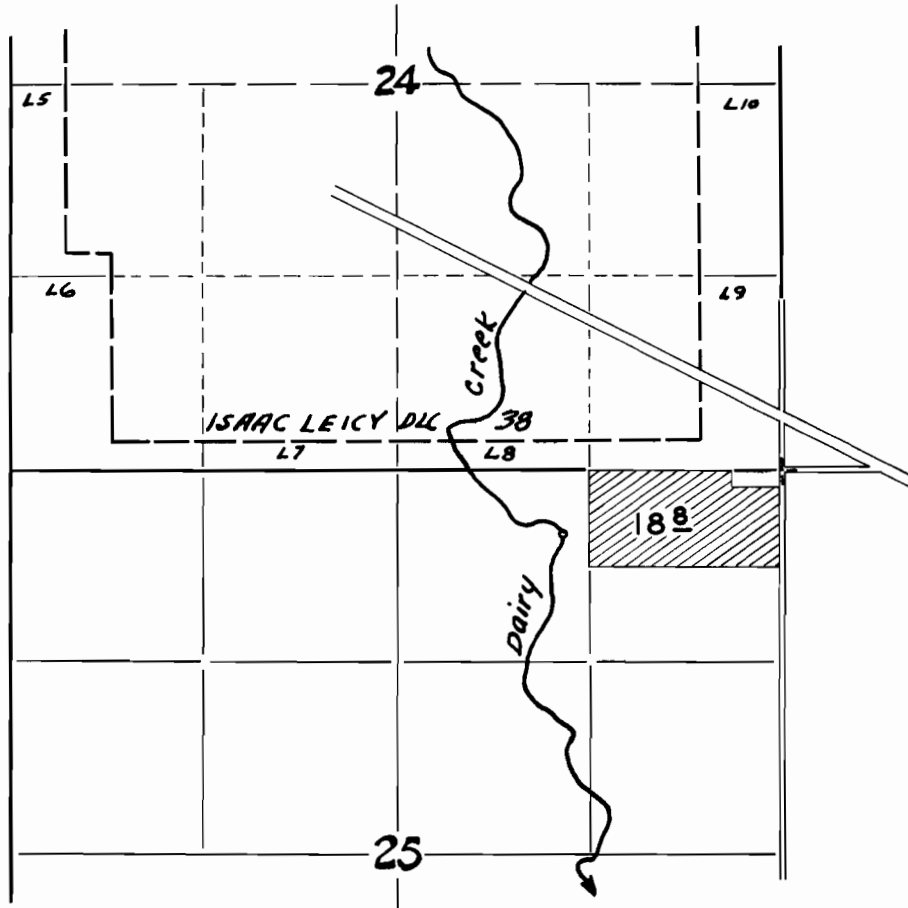

**FINAL PROOF SURVEY**

UNDER

Application No. 25680 Permit No. 20131

IN NAME OF

.....CECIL C. LODGE.....

Surveyed 4 - 12 1956, by R.H. WHITBY