


T. 1 S., R. 2 W., W.M.

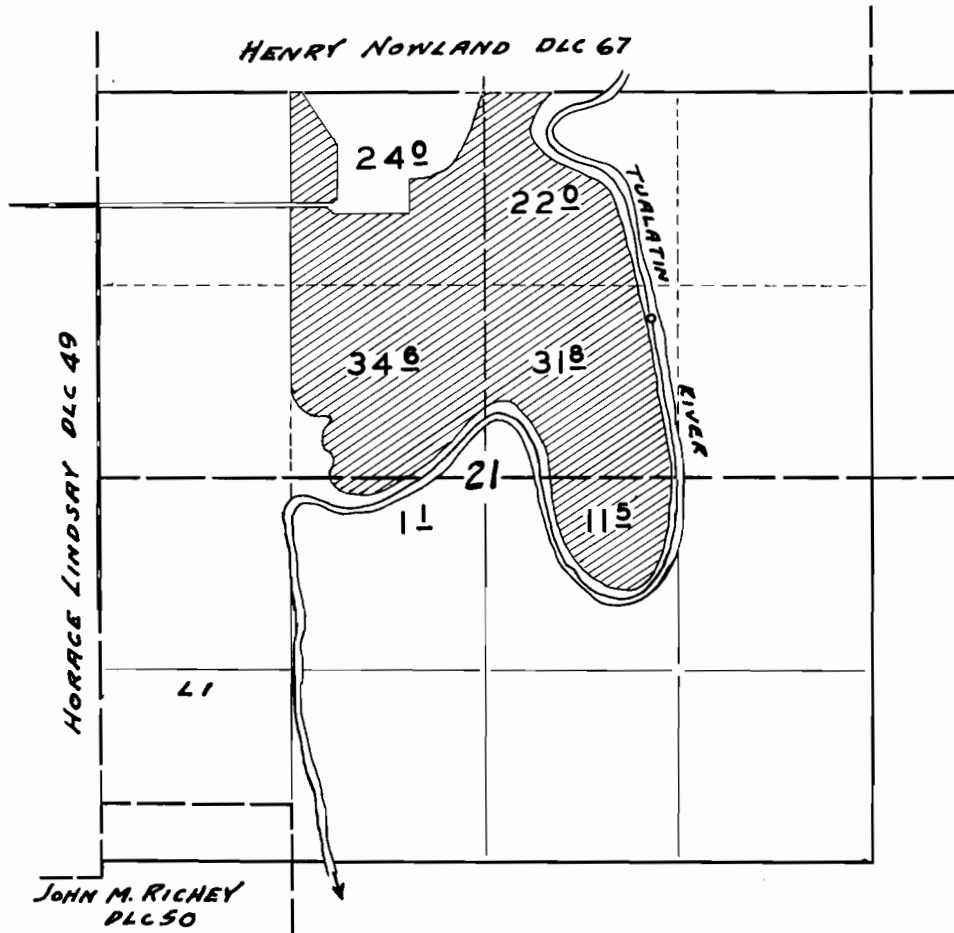

FINAL PROOF SURVEY

UNDER

Application No. 26214 Permit No. 20441

IN NAME OF

Raymond W & Edna E Van Dyke

Surveyed 4 - 19 1956, by M. BISH