


T.22S. R.9W.W.M.

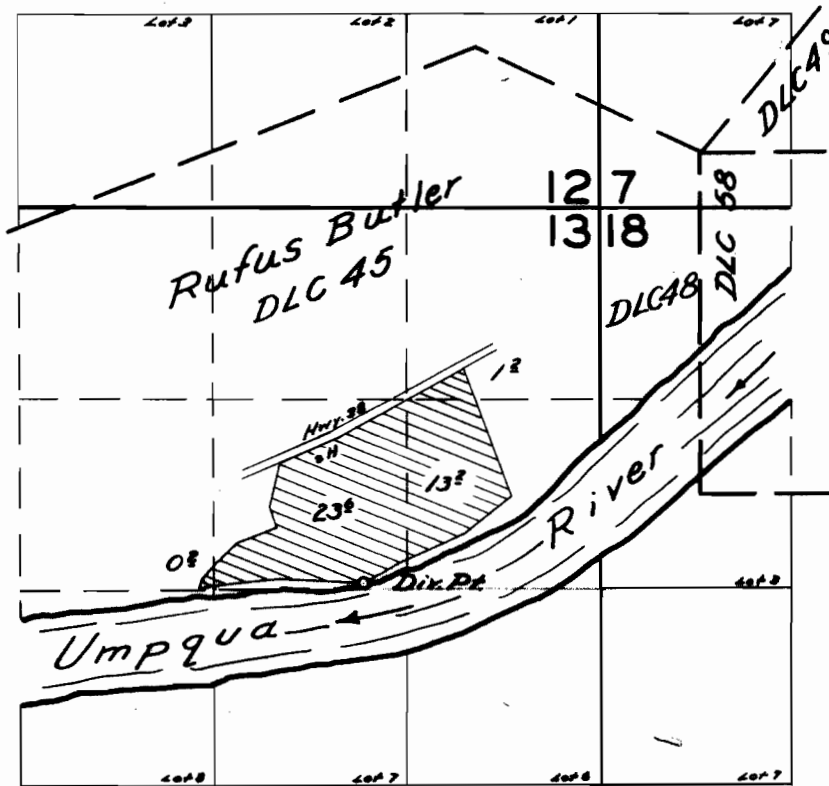

FINAL PROOF SURVEY

UNDER

Application No. 26010 Permit No. 20555

IN NAME OF

Walter Haines & Janie Haines

Surveyed July 15 1956, by C.O. Bartels