


T.2S. R.1 W. W.M.

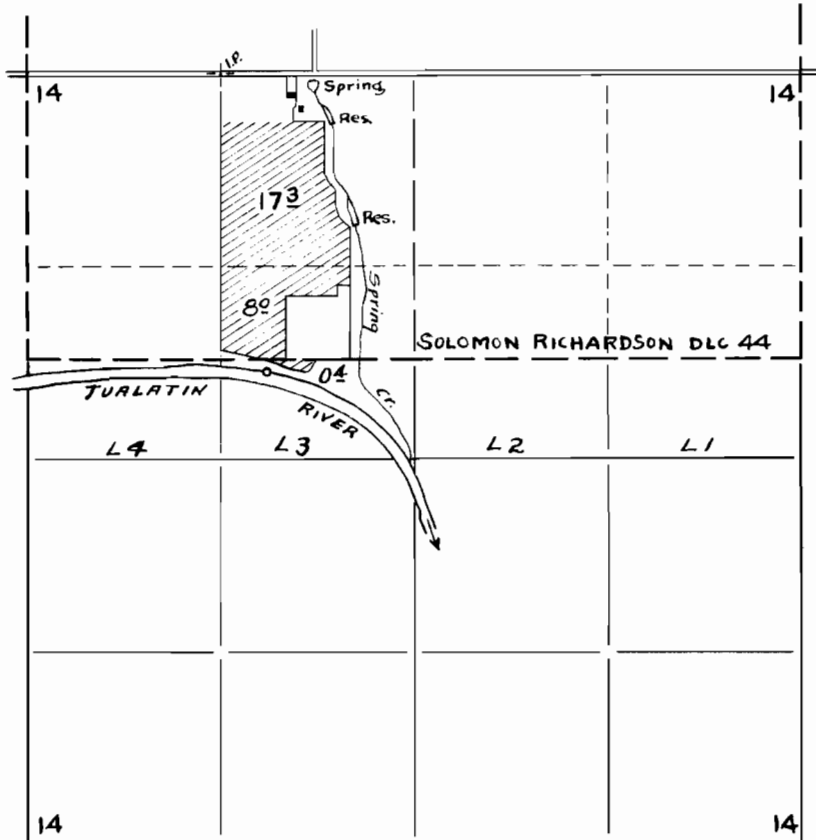

FINAL PROOF SURVEY

UNDER

Application No. 26364 Permit No. 20690

IN NAME OF

HENRY FRISON

Surveyed 5 - 8 1956, by R.H. WHITBY