


T.1N., R.3 W., W.M.

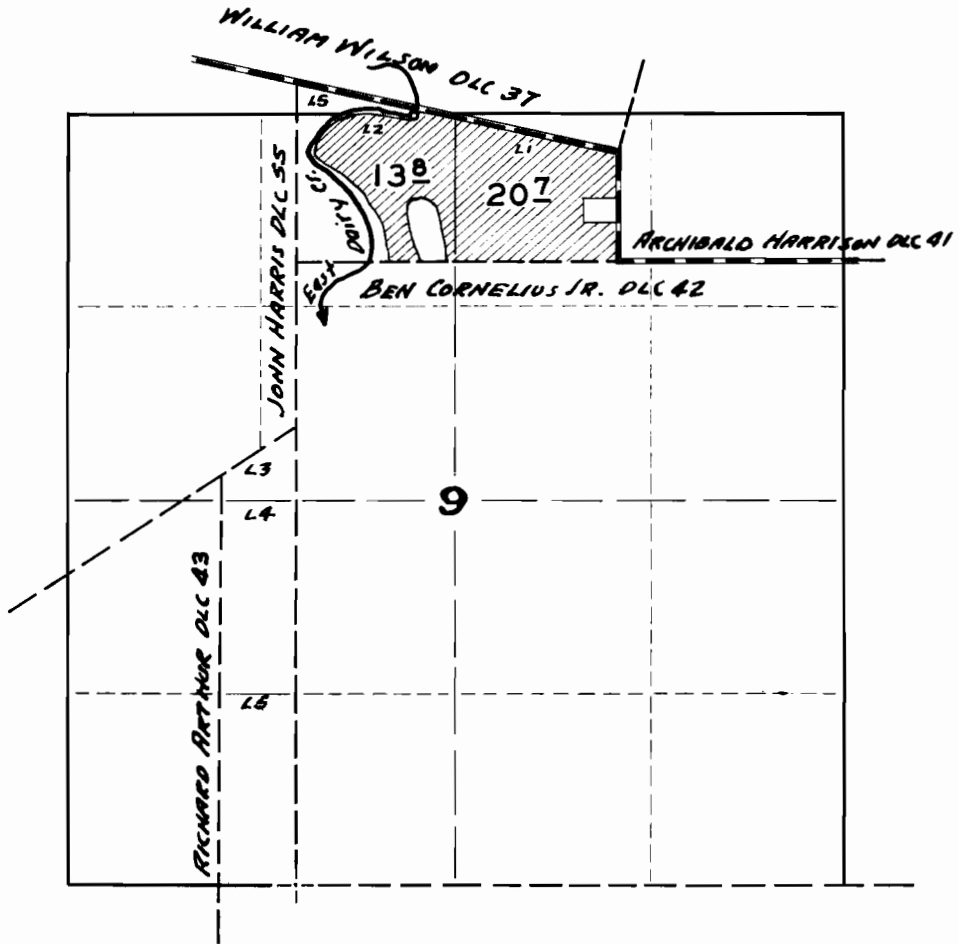

FINAL PROOF SURVEY

UNDER

Application No. 26734 Permit No. 21026
IN NAME OF

MERTON SAHNOW

Surveyed 4 - 17 1956, by R.H. WHITBY.