


T.2S., R.1E., W.M.

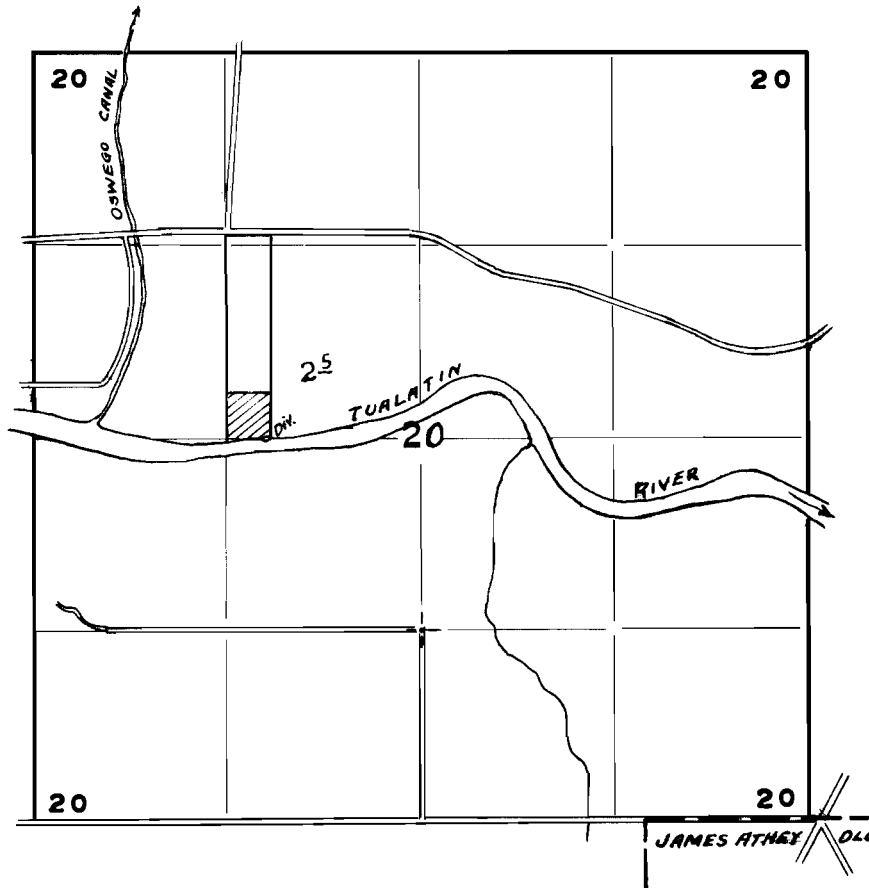

**FINAL PROOF SURVEY**

UNDER

Application No. 26858 Permit No. 21092

IN NAME OF

A. G. & M. K. HORTON

Surveyed 5 - 7 1956, by R. D. BEST