


T. 3&4S. R. 2W. W.M.

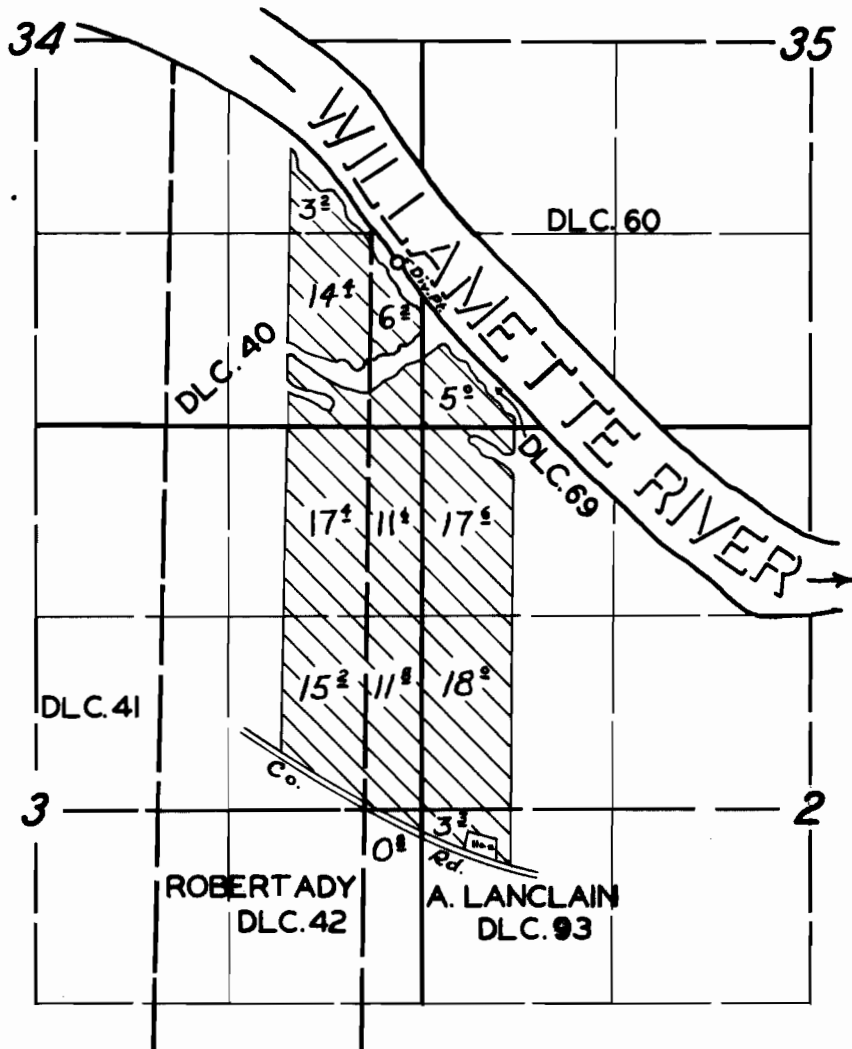

FINAL PROOF SURVEY

UNDER

Application No. 26835 Permit No. 21075

IN NAME OF

GEORGE A. & GLADOLIA DURIG

Surveyed 27 Sept 1956, by M. Bish

DFN-2D-85

RB