


T.10S. R.2W.W.M.

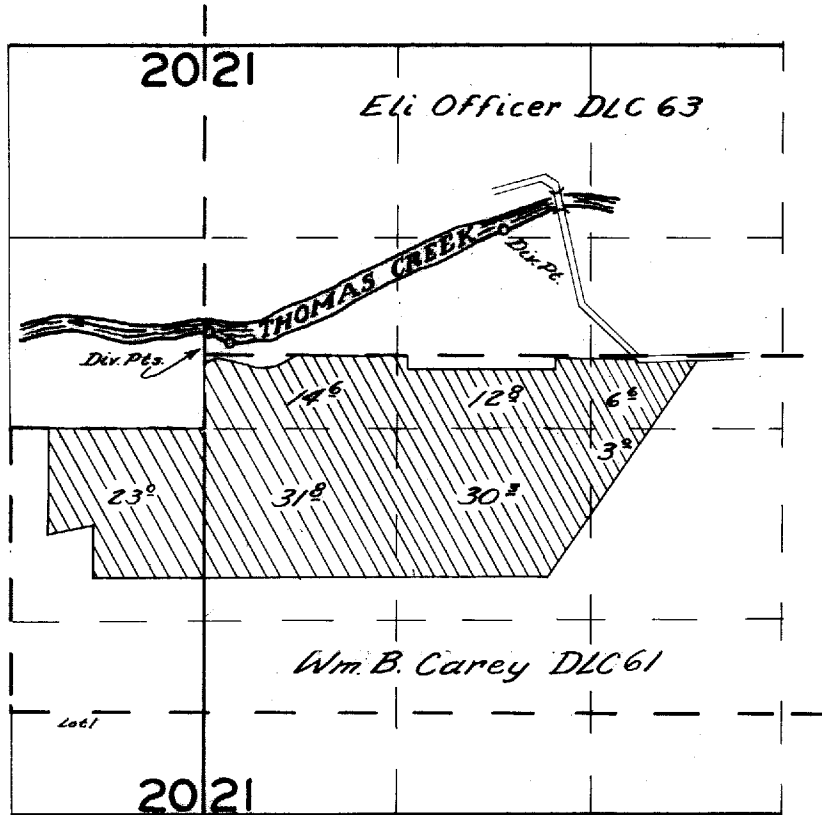

**FINAL PROOF SURVEY**  
UNDER

Application No. 25825. Permit No. 21117.....  
IN NAME OF

*Marion Tokery*

Surveyed July 25 1956, by R.H. Whitby

DFN-3D-206