


T. 1 S., R. 2 W., W.M.

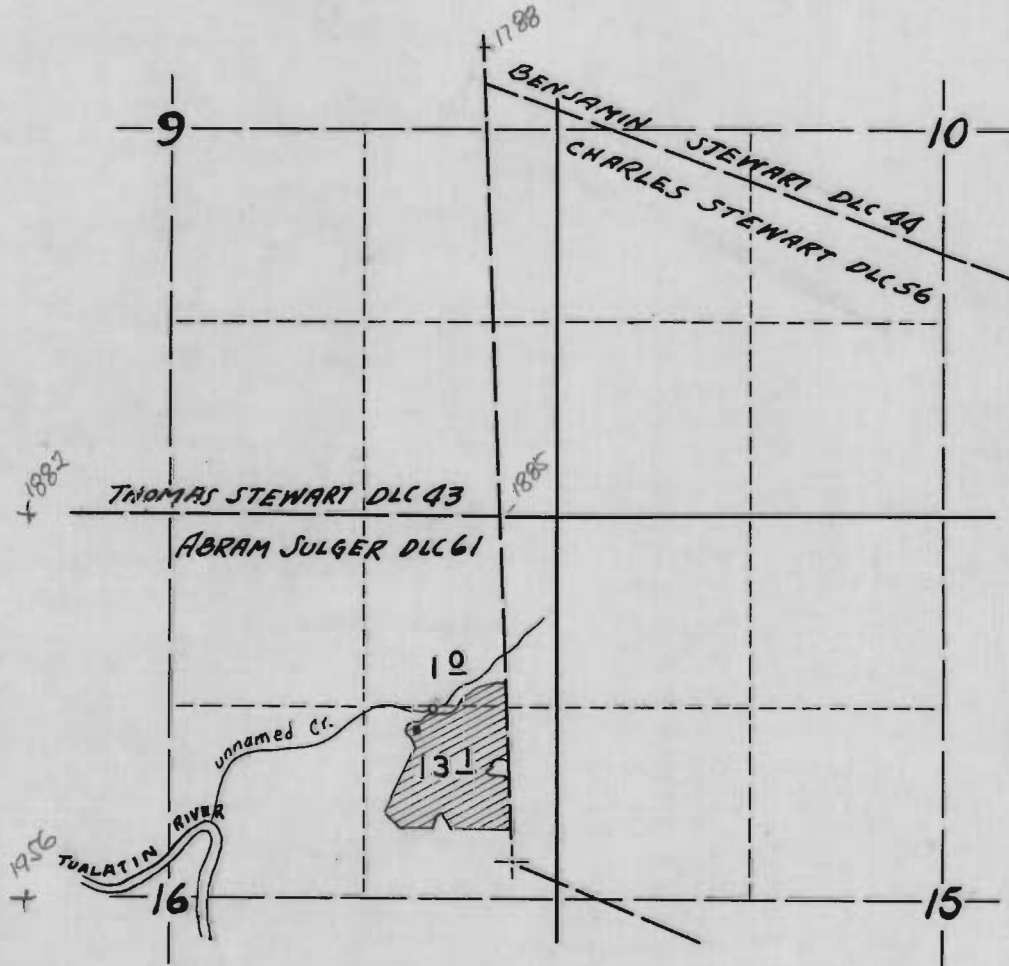

FINAL PROOF SURVEY
UNDER

Application No. 269.36 Permit No. 21163.
IN NAME OF

CHARLES E. WALTERS

Surveyed 4 - 18 1956, by M. BISH