


T. 6. N. R. 2 W. W. M.

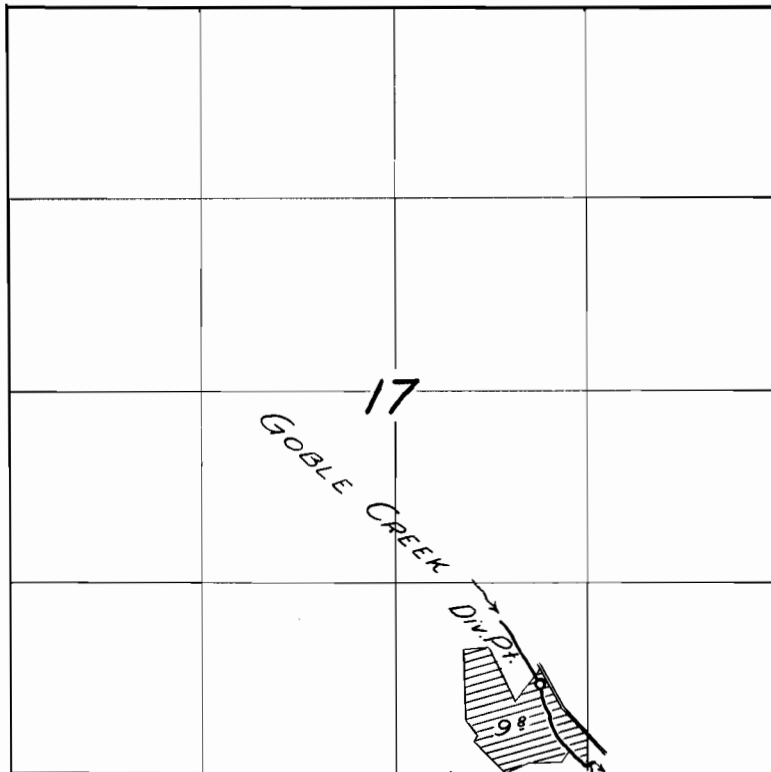

FINAL PROOF SURVEY
UNDER

Application No. 26953 Permit No. 21175
IN NAME OF

MILFRED L. GREGORY

Surveyed 9 Aug. 1956, by P. W. Kelly