


T. 2 N. R. 3 W. W.M.

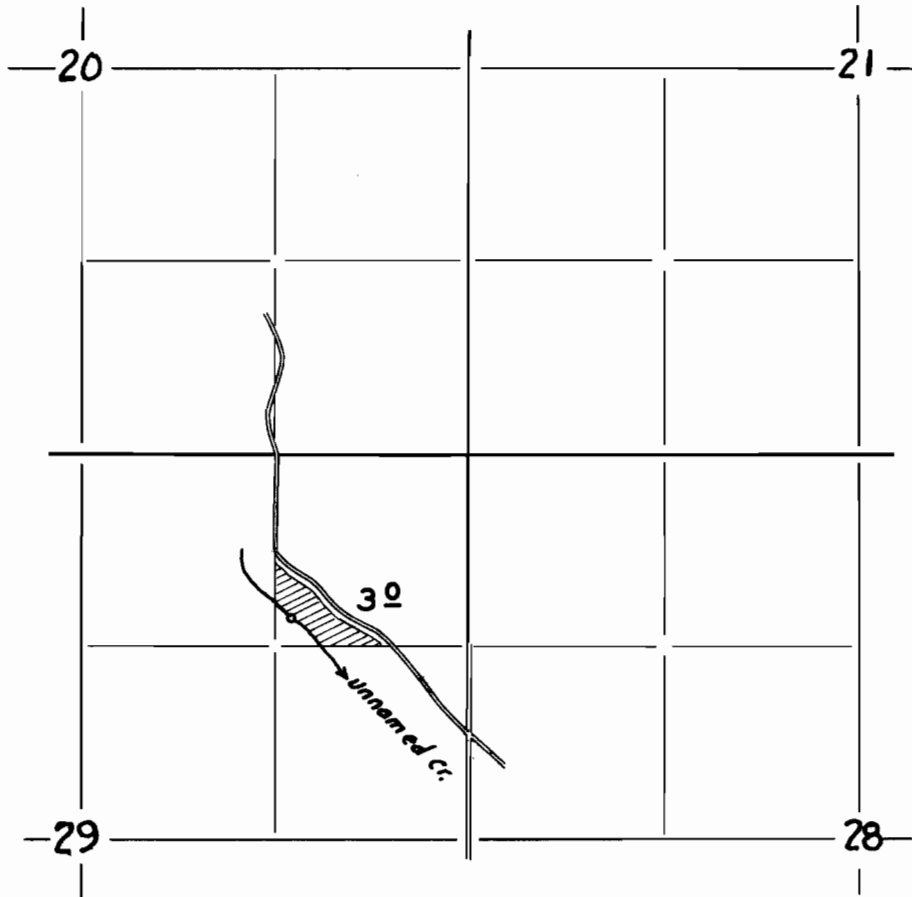

FINAL PROOF SURVEY

UNDER

Application No. 25983 Permit No. 21243

IN NAME OF

JOSEPH F. VANDOMELEN

Surveyed 4 - 18, 1956, by R. H. WHITBY.