


T. 1 S., R. 2 W., W.M.

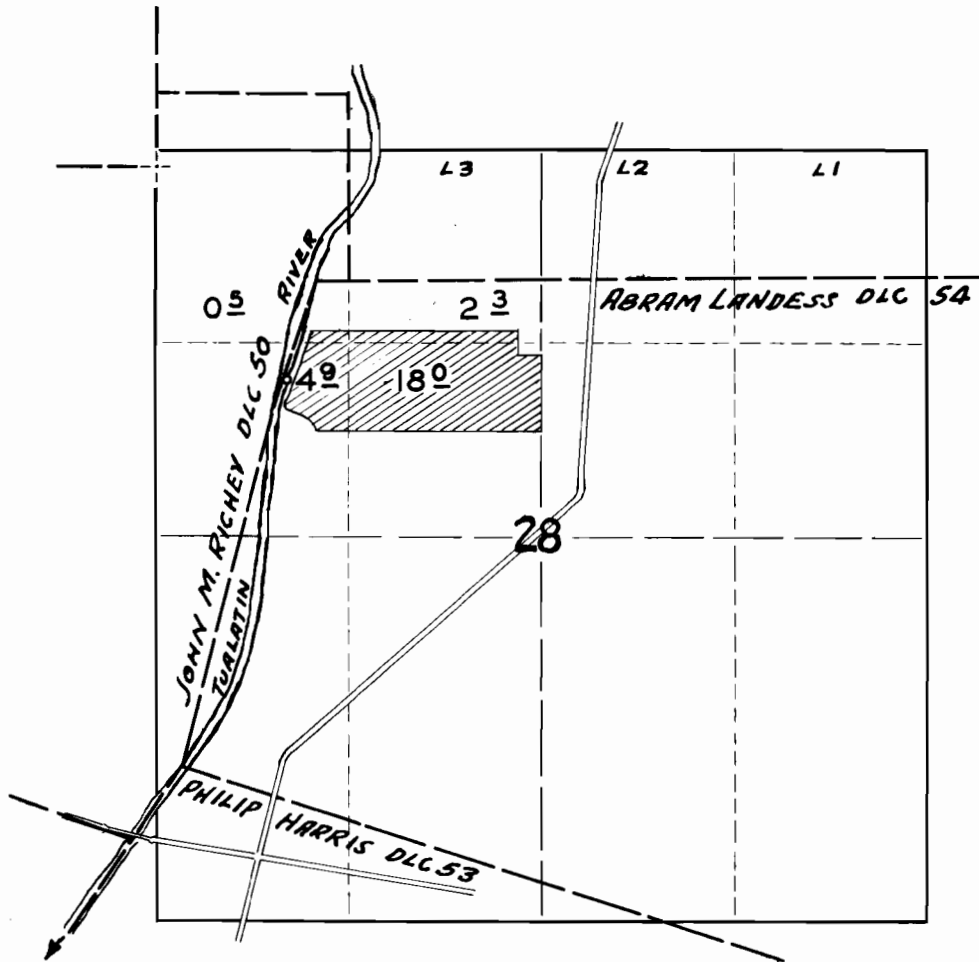

FINAL PROOF SURVEY

UNDER

Application No. 27071 Permit No. 21301

IN NAME OF

J.E. & VERA A. O'MEARA

Surveyed 4 - 20 1956, by M. BISH