


T.3S.R.10W.W.M.

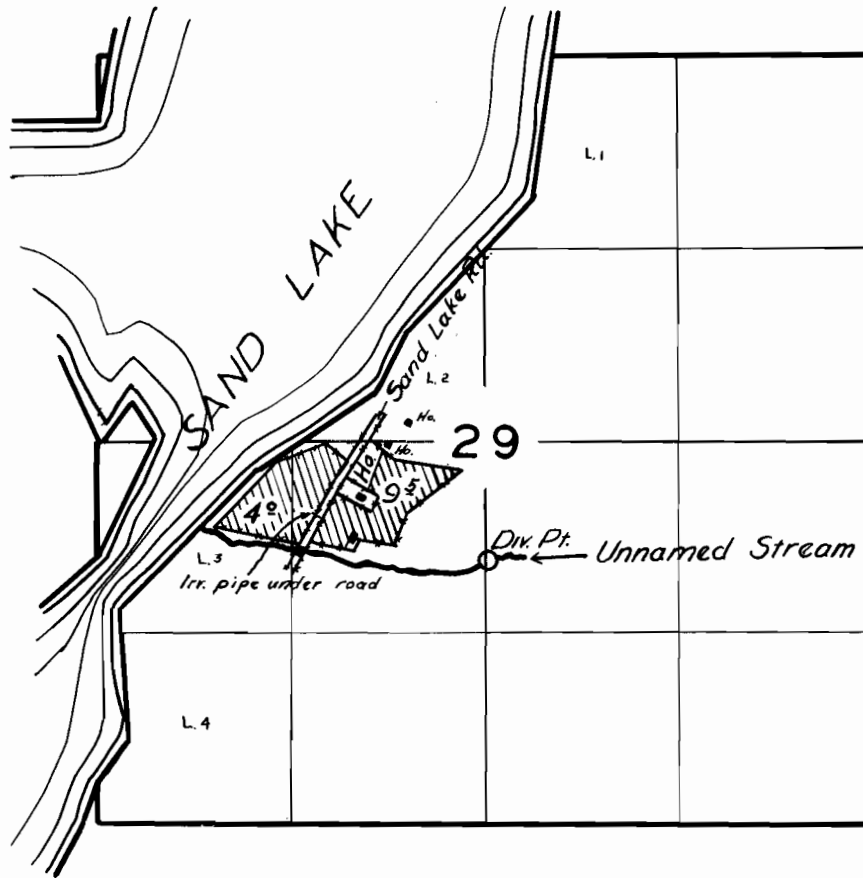

FINAL PROOF SURVEY

UNDER

Application No 22709 Permit No 17926

IN NAME OF

ALBERT KRAKE

Surveyed 18, Aug 1955, by *L. A. Whitby*