

WATER RIGHT M. J. & OPAL B. LINDSTROM


SEC 22, T5N, R9W

SCALE 1" = 200'

Origin of Coordinates
1/4 cor Sec 15/22 T5N R9W.

I, W.A. Markham, of Arch Cape, Ore. hereby
certify that this map was made from notes
of an actual survey made by me May 15, 1952,
and that the monuments shown, consisting of
Iron pipes 1" x 3' are South 1833.1' and East
1863.8', and South 1942.1 and East 2056.7',
from the 1/4 corner Sec 15/22 T5N R9W.

W.A. Markham
Reg. Engr. No. 1842.

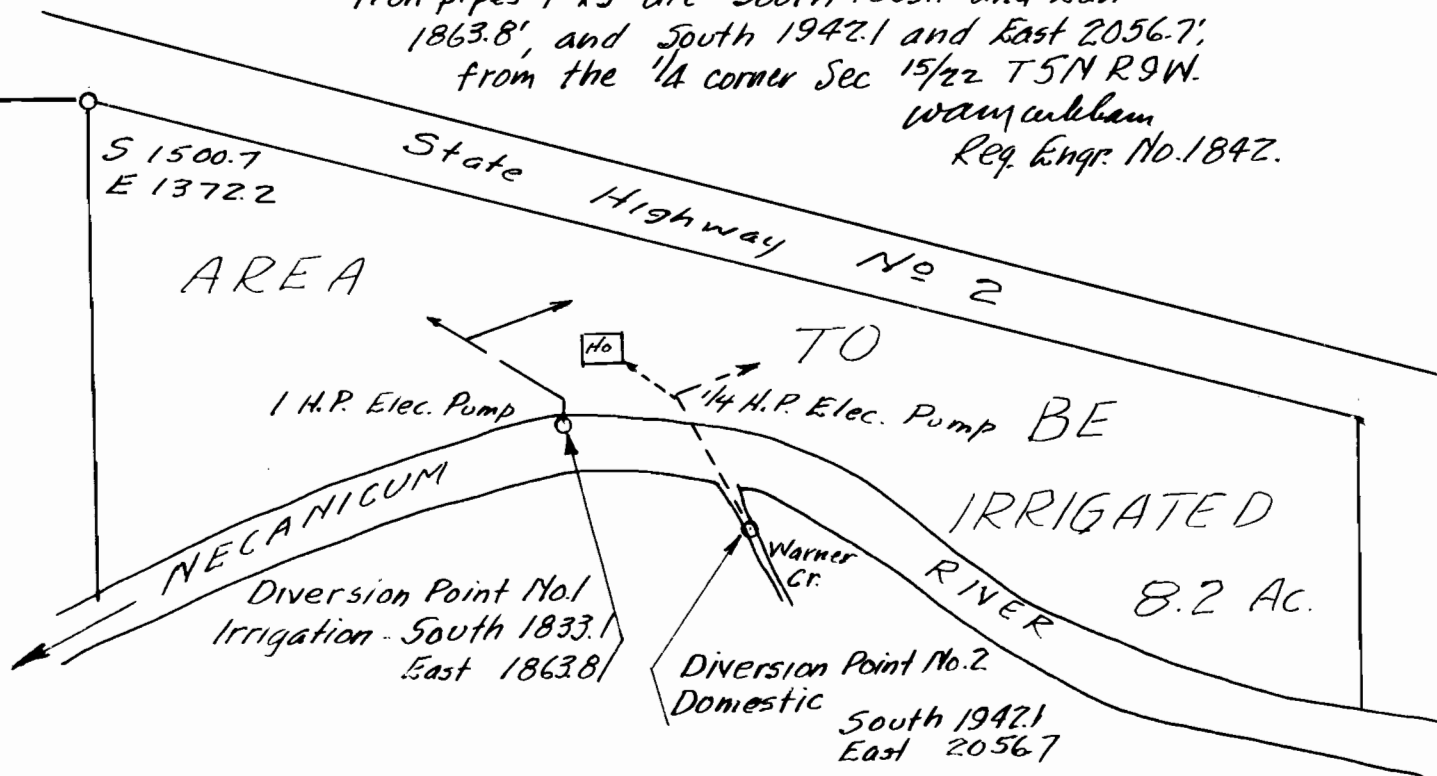

27234

21428