



4	3	2	1
9	10	11	12
16	15	14	13
21	22	23	24

Township 3. S. ,

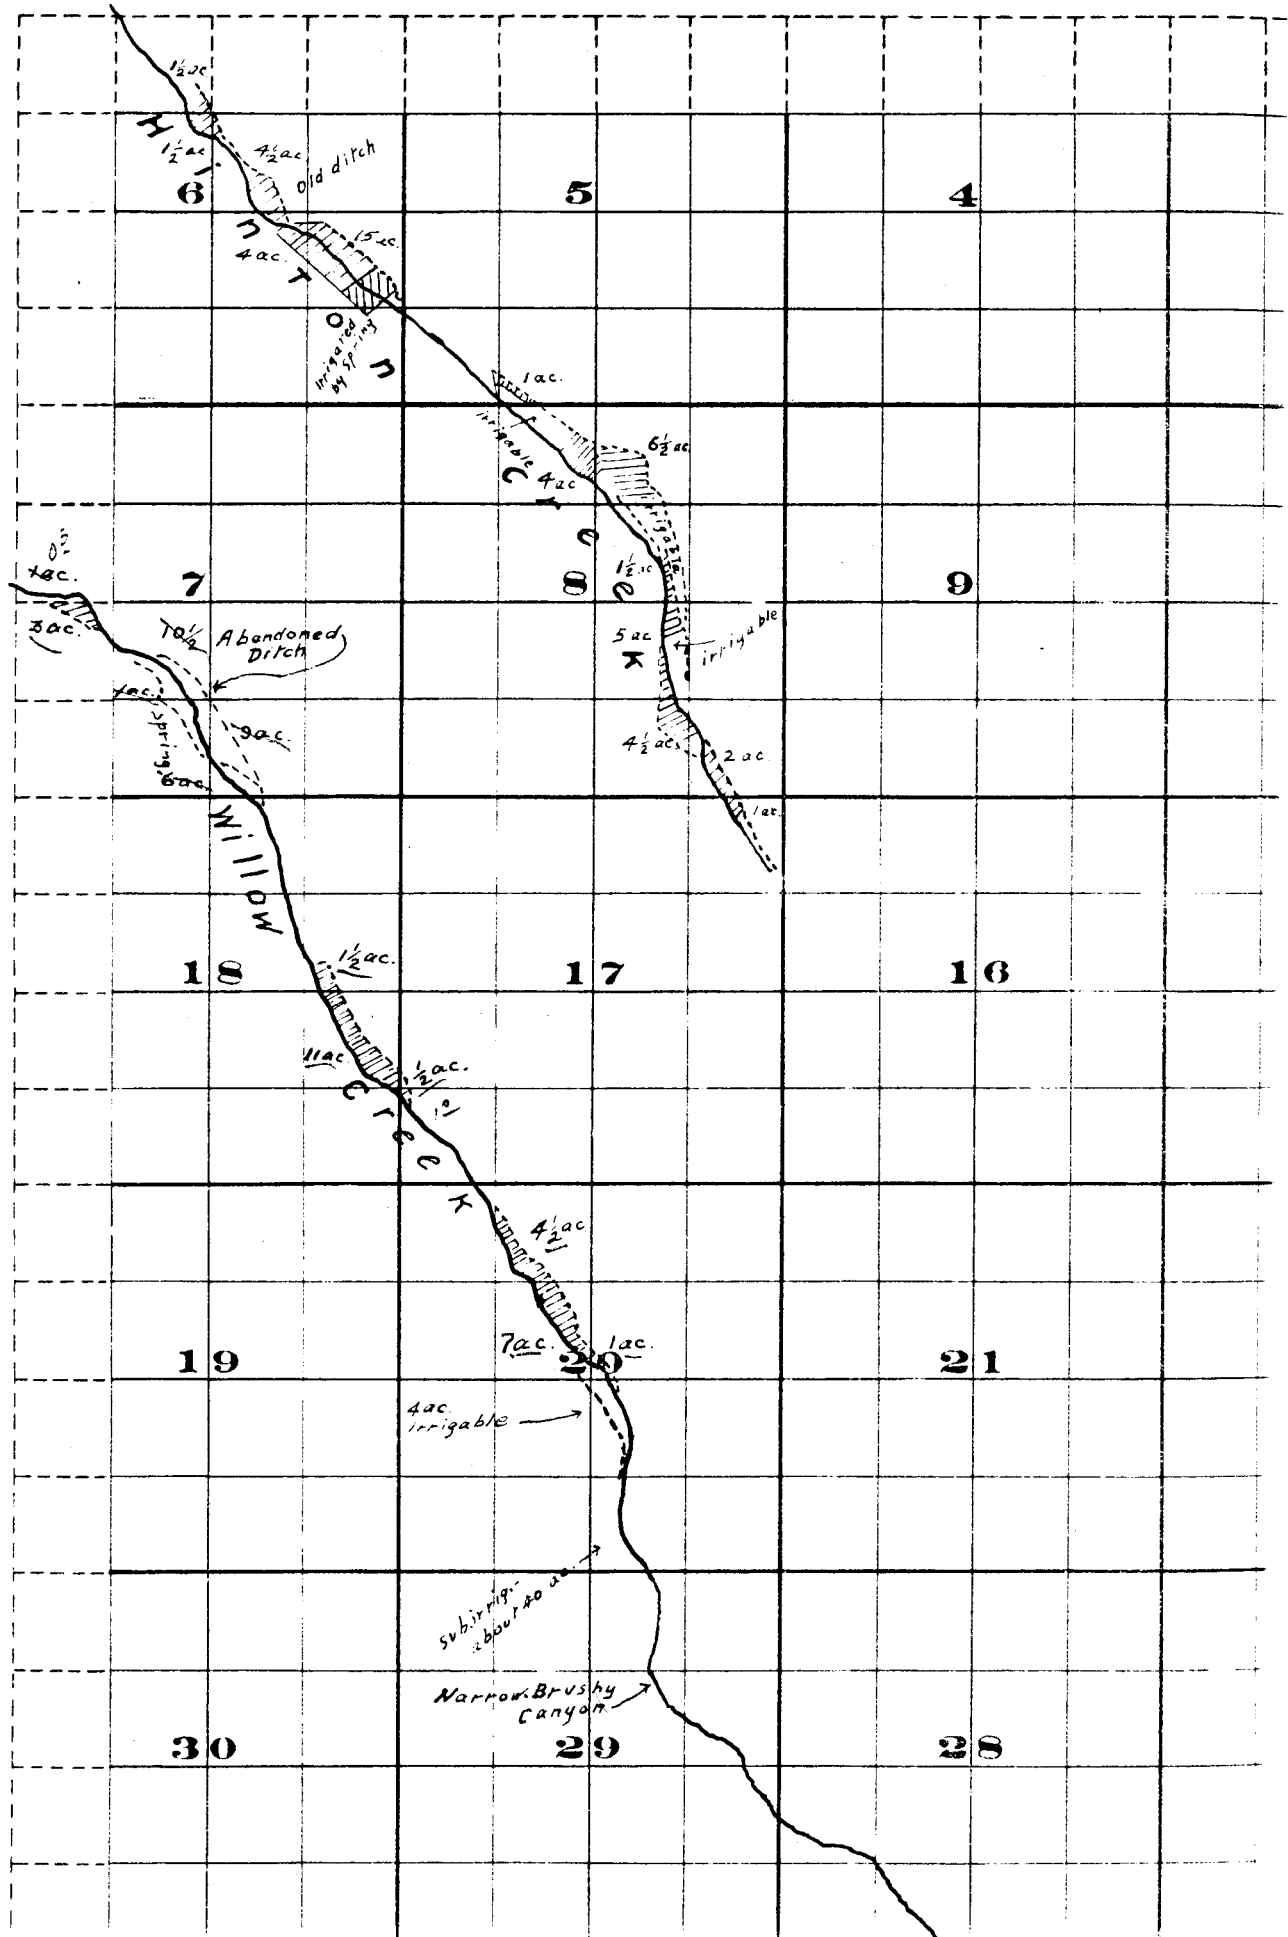

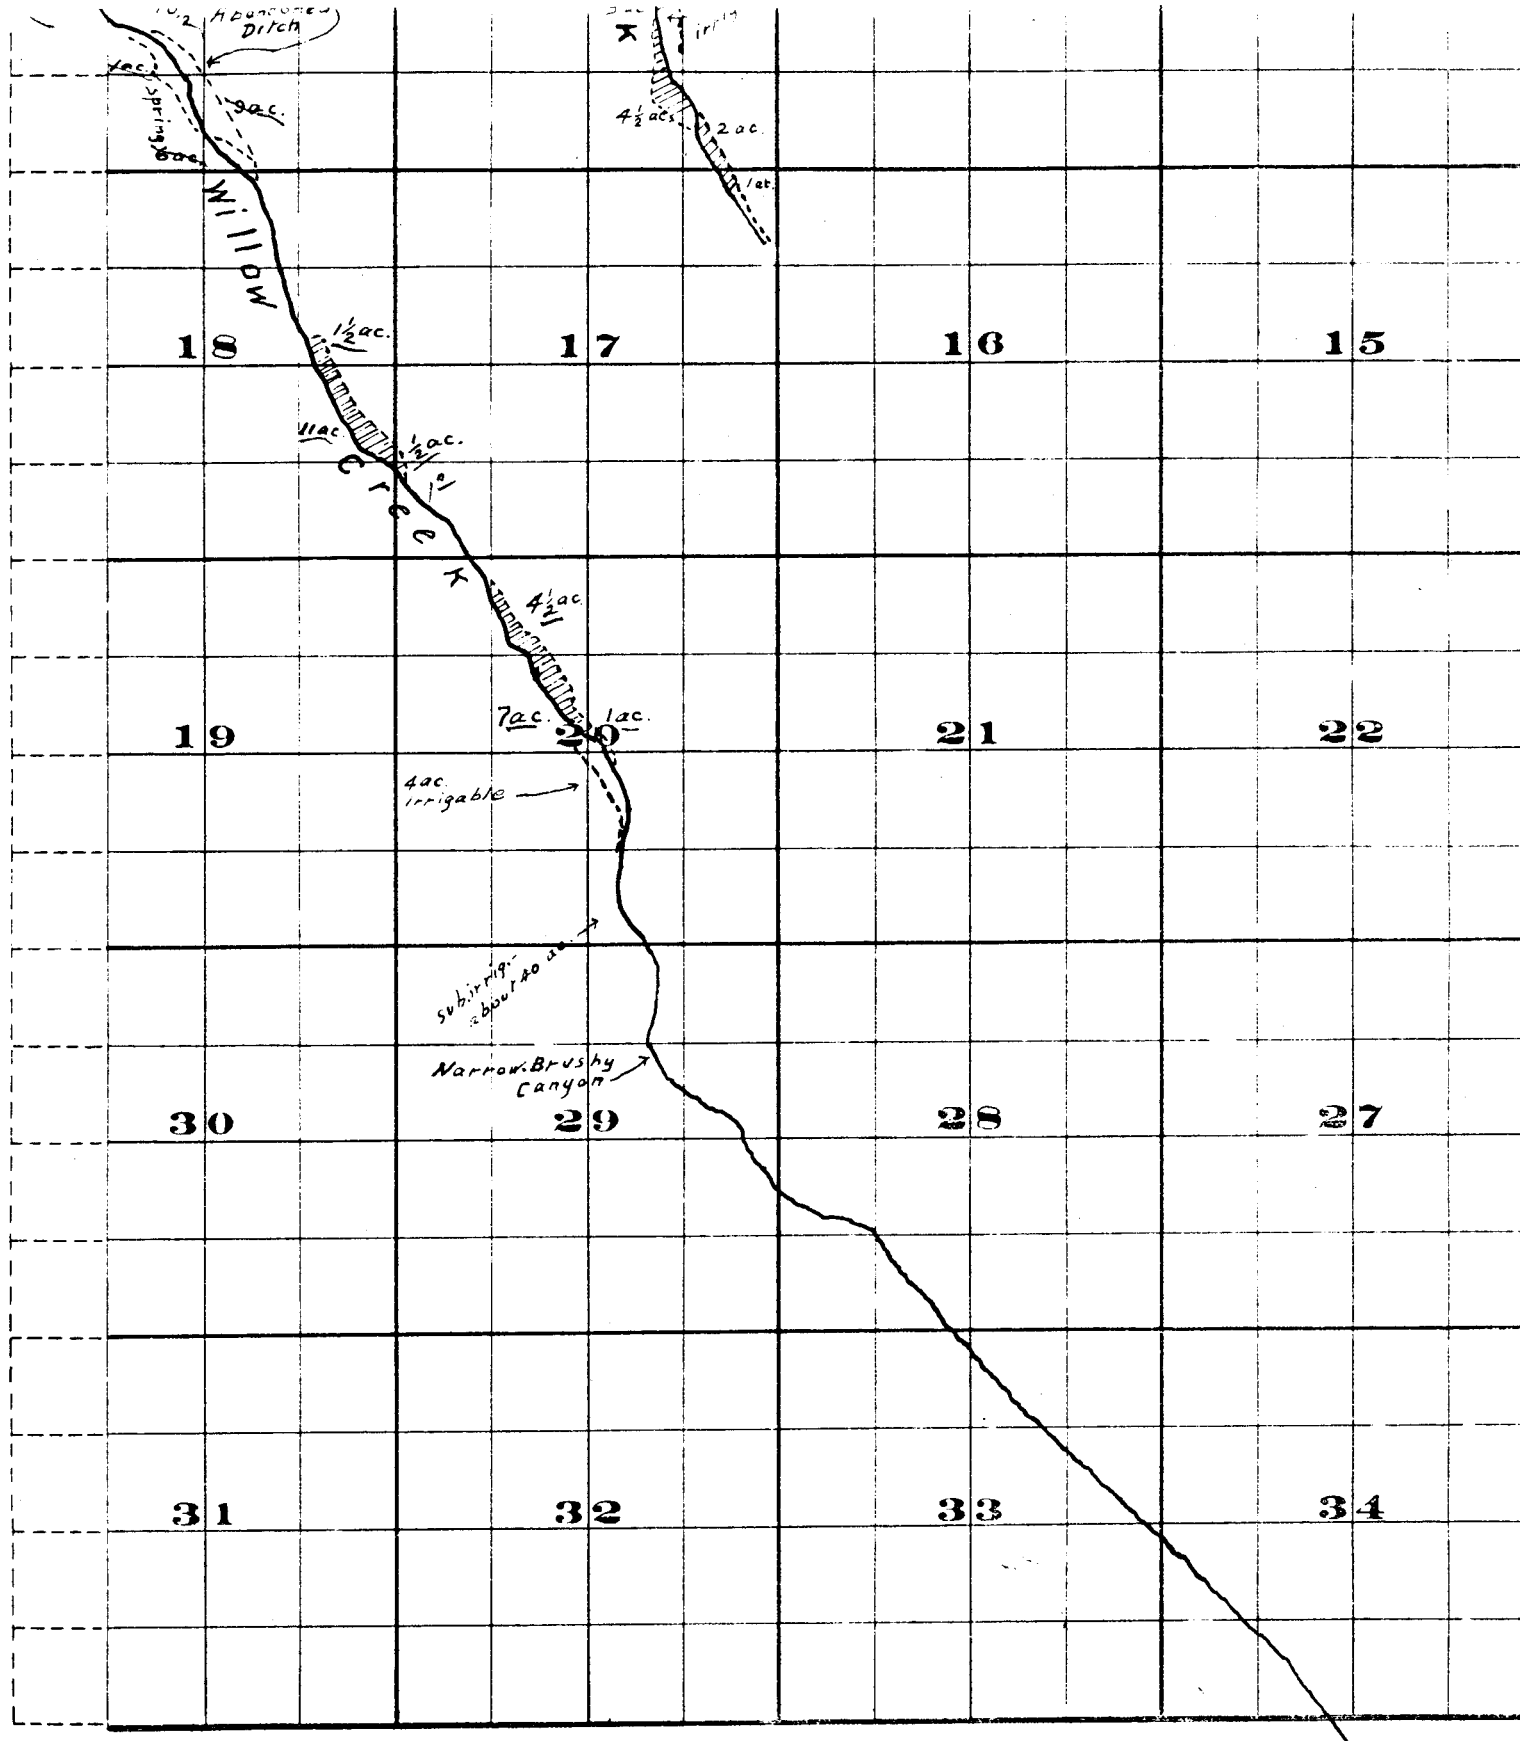

THIS & BRISTOL CO. PRINTERS & BOUNDINGERS, NEWTON, N.H.

Hinton Creek Surveyed by H.K. Donnelly July 1909
 Willow Creek Surveyed by R.D. Cooper July 1909

John H. Lewis - State Eng'r.

Examined July 14, 1909.

15				14				13	
22				23				24	
27				26				25	
34				35				36	

FROM OFFICE OF THE STATE ENGINEER, SALEM, OREGON

Willow Creek Adjudication.

35.28 E.