


T. 30 S. R. 5 W. W. M.

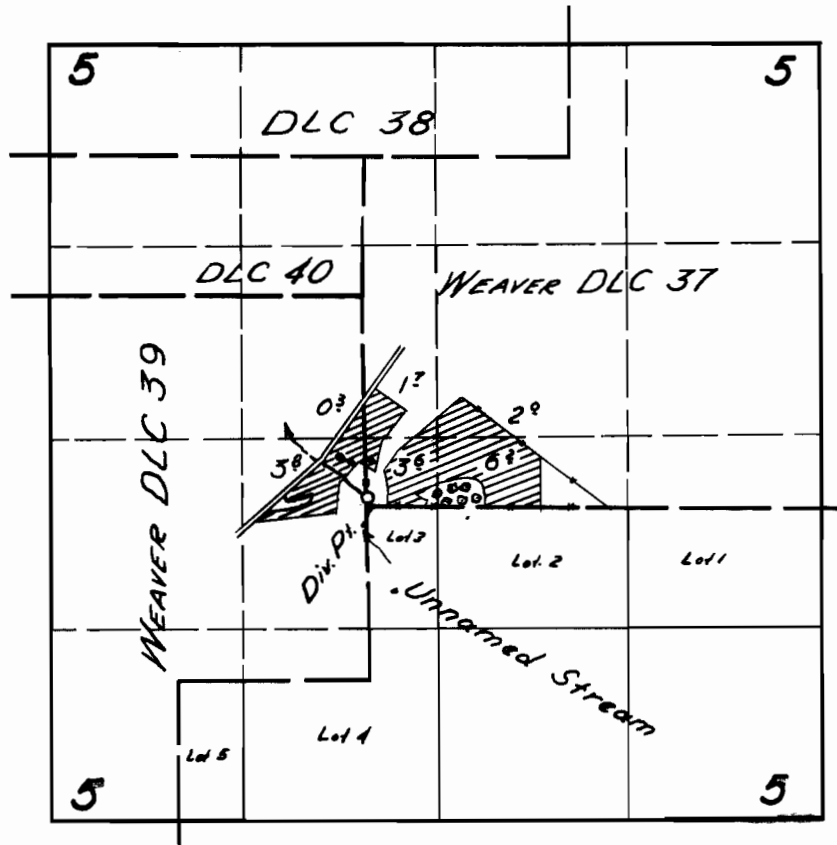

FINAL PROOF SURVEY

UNDER

Application No. 27271 Permit No. 21452

IN NAME OF

GEORGE R. AKER, SR.

Surveyed 4 Oct 1956, by CR Whitby