


T. 7N R.3W W.M.

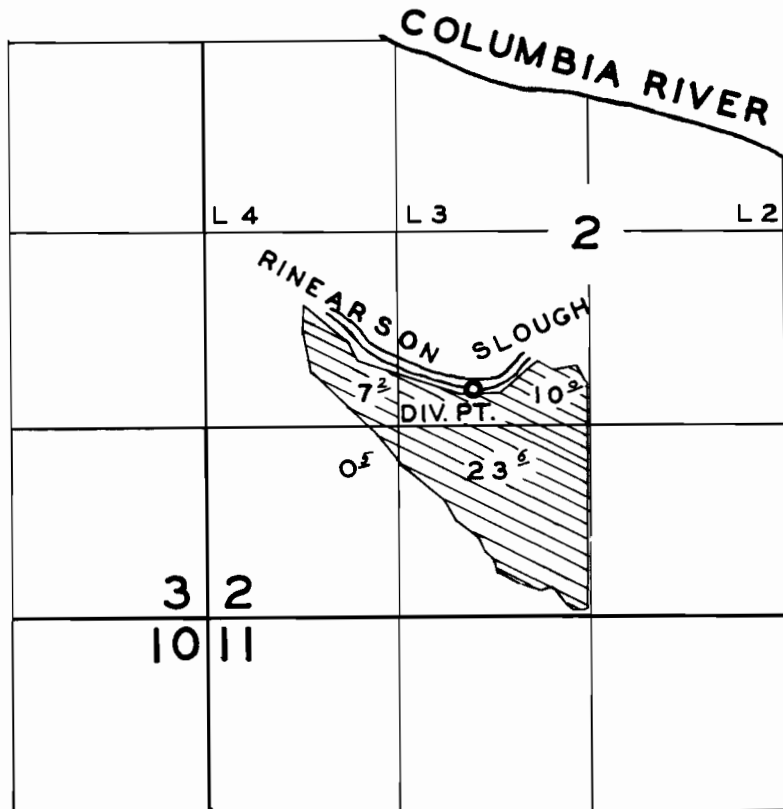

FINAL PROOF SURVEY
UNDER

Application No. 27430 Permit No. 21598
IN NAME OF

WM. L. THOMPSON

Surveyed AUG. 24 1956, by R. H. WHITBY