


T. I. S., R. I. W., W. M.

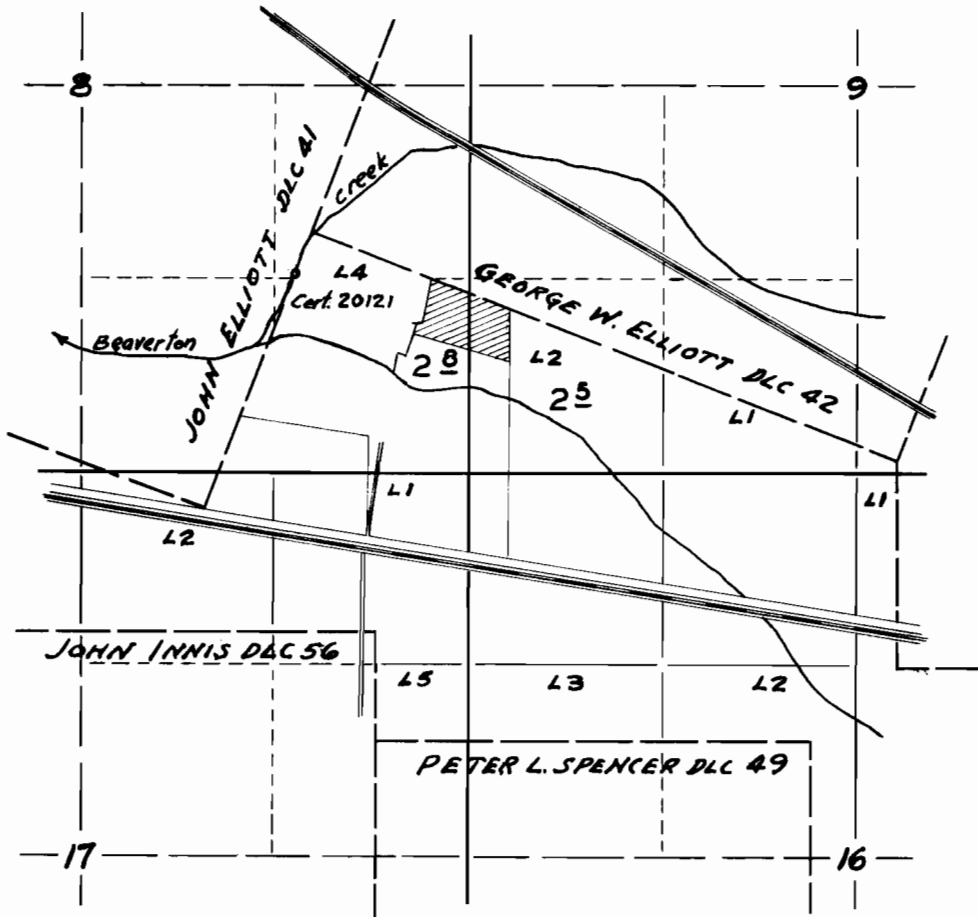

**FINAL PROOF SURVEY**

UNDER

Application No. 27431 Permit No. 21599

IN NAME OF

SISTERS OF ST. MARY

Surveyed 4-16 1956 by M. BISH