


T 3S. R. 2E. W.M.

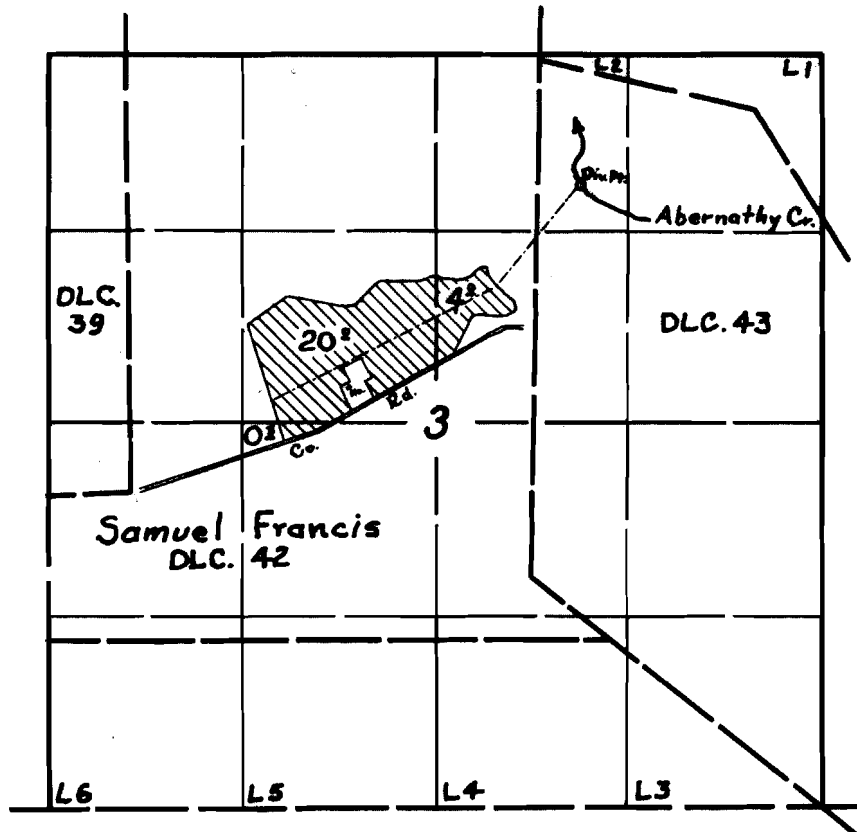

**FINAL PROOF SURVEY**

UNDER

Application No. 27472 Permit No. 21672

IN NAME OF

MR & MRS. L. CARLE BUTTS

Surveyed 20 June 1956, by M. Bish

DFK-1D-41

20