


T.7S. R.1W.W.M.

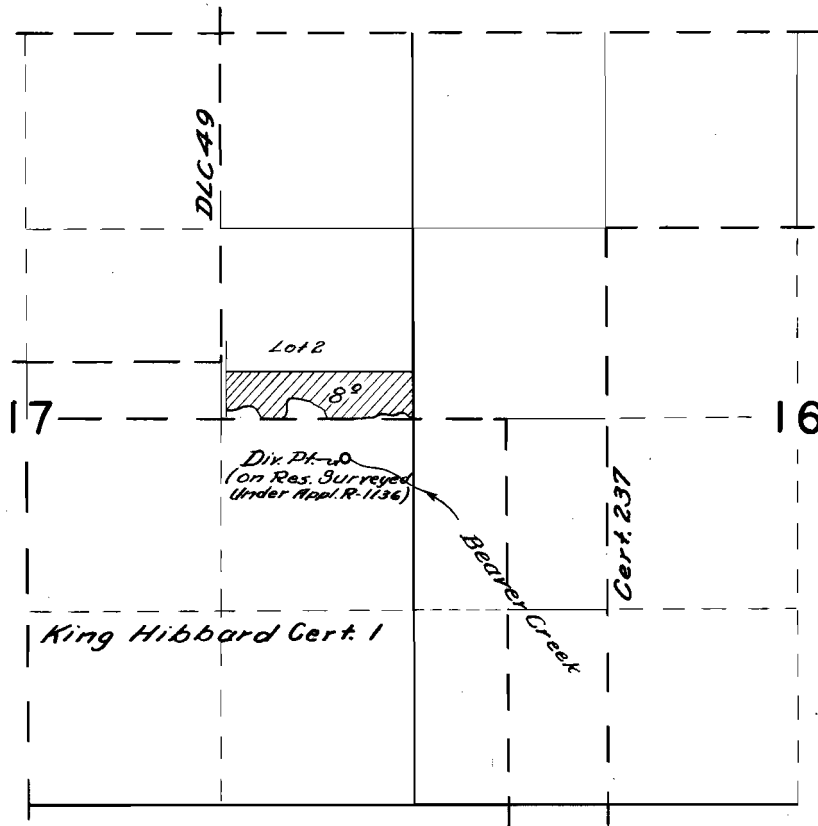

**FINAL PROOF SURVEY**

UNDER

Application No. 27518 Permit No. 21678

IN NAME OF

Lawrence E. Kuenzi

Surveyed May 23 1956, by R.H. Whitby

DFN-2D-196

CB