


T. 29 S., R. 5 W., W. M.

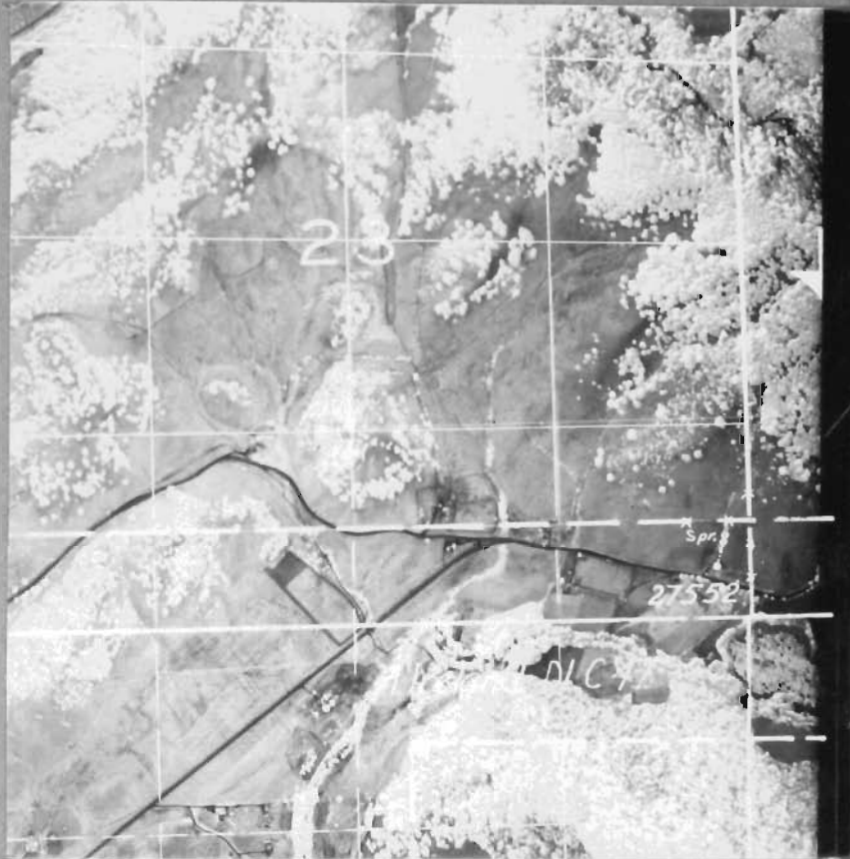

FINAL PROOF SURVEY
 UNDER

Application No. 27552 Permit No. 21701
 IN NAME OF
 MARTIN MILLSAP

Surveyed Sept. 3 1953, by T. Jones