


T. I. S. R. 3 E. W. M.

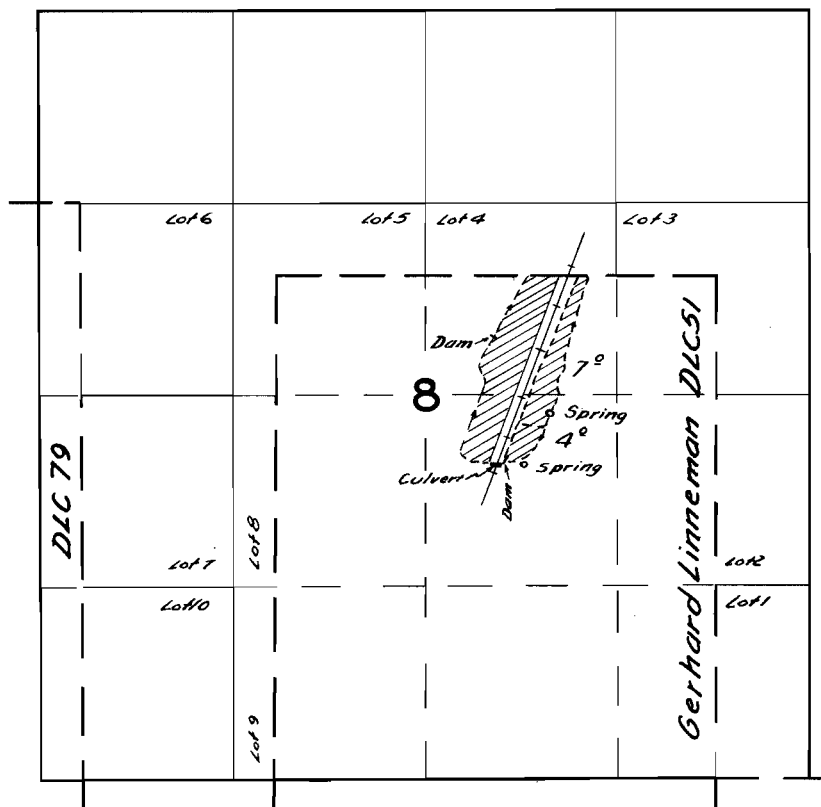

FINAL PROOF SURVEY
UNDER

Application No. 27557 Permit No. 21709
IN NAME OF

Arthur W. Grant

Surveyed June 26 1956, by R. H. Whitby

DFK-1D-142