


T. 1 N. R. 3 W. W.M.

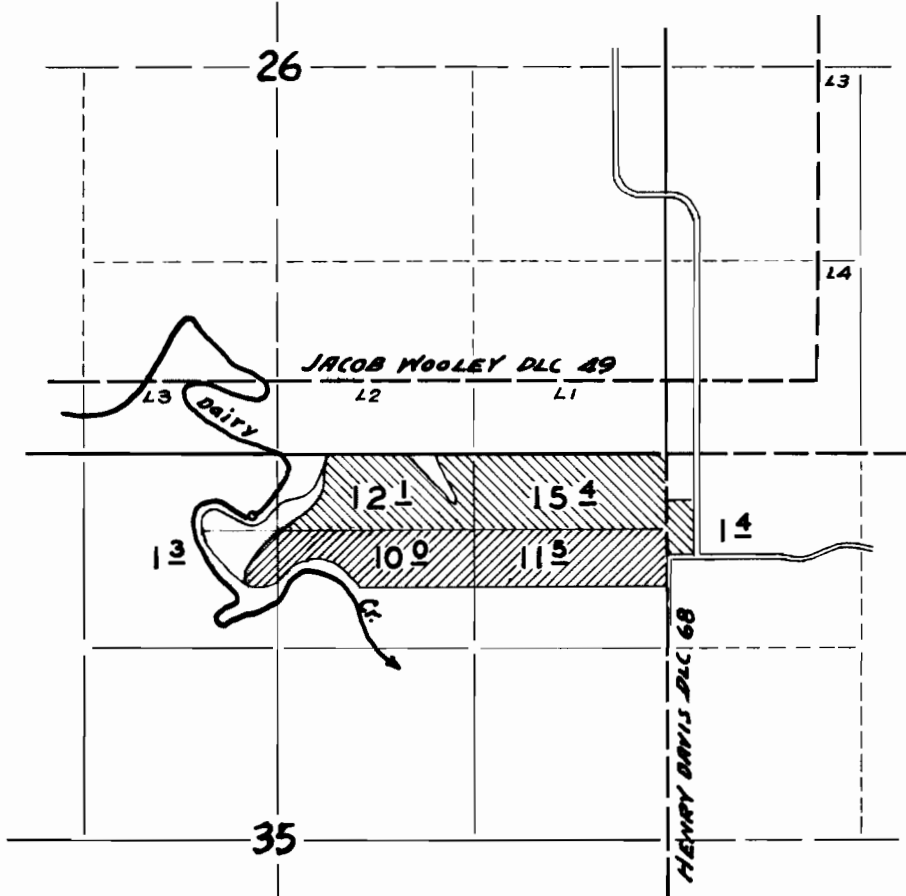

**FINAL PROOF SURVEY**

UNDER

25630

20106

Application No. 27680

Permit No. 21795

IN NAME OF

CLARENCE J. WAIBEL

Surveyed 4 - 11 1956 by R.H. WHITBY