


T. I. S., R. I. W., W. M.

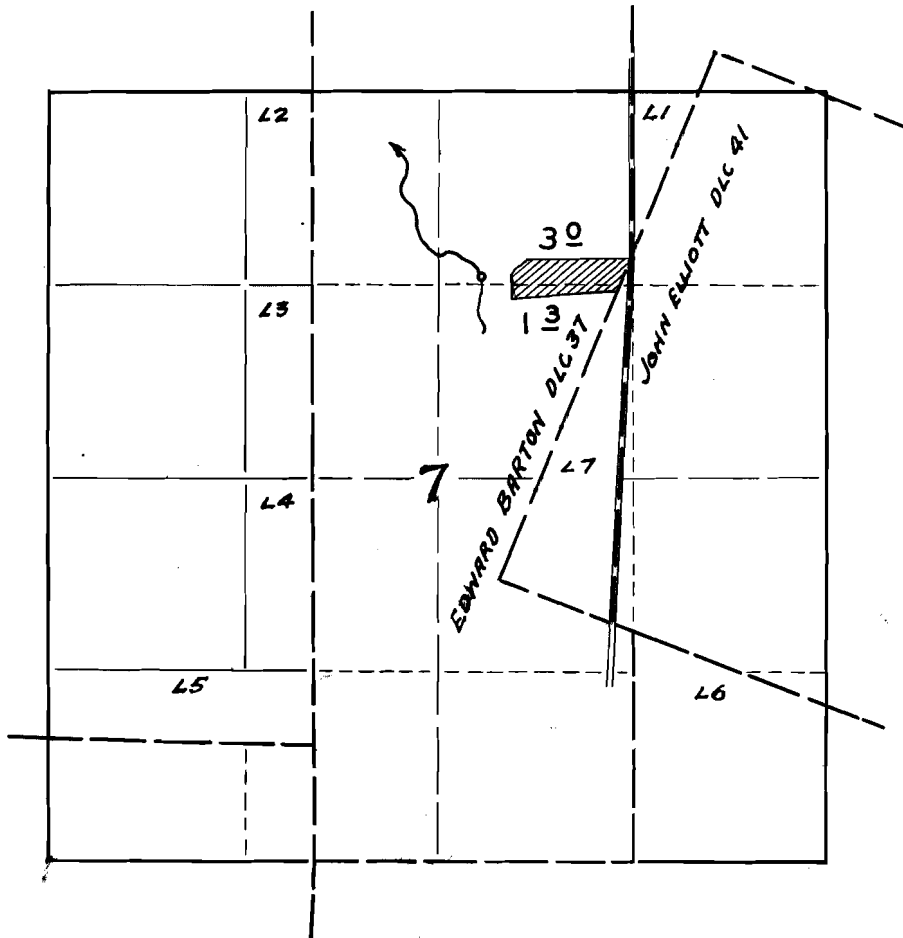

FINAL PROOF SURVEY

UNDER

Application No. 27500 Permit No. 21937

IN NAME OF

GORDON A. SPINNEY

Surveyed 4 - 17 1956, by M. B. I. S. H.