


T.1 N. & T.1 S., R.2 W., W.M.

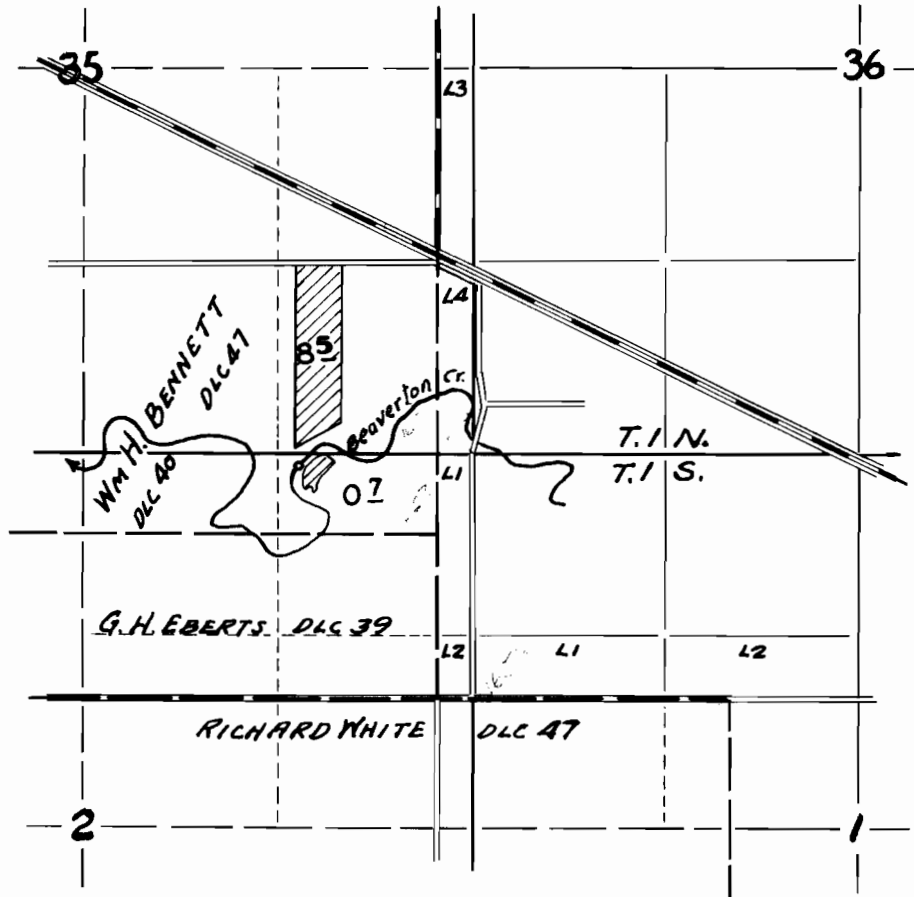

**FINAL PROOF SURVEY**

UNDER

Application No. 28021 Permit No. 22050  
IN NAME OF

EARL L. HORNING

Surveyed 4 - 17 1956, by M. BISH