


T. 1 & 2 S..R.2 W. W.M.

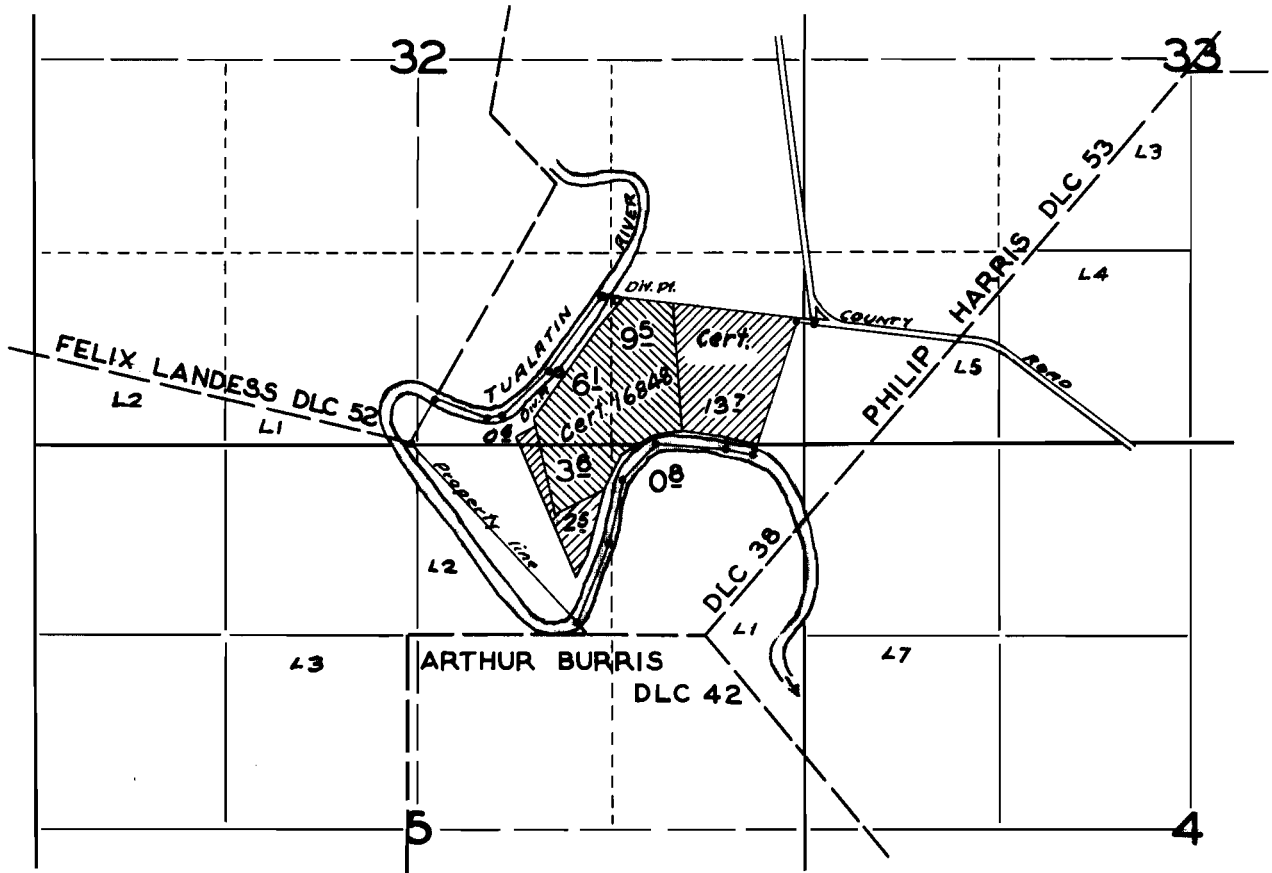

MAP SHOWING LANDS OWNED BY
ORVILLE MUILENBURG
TO WHICH WATER RIGHTS ARE APPURTENANT
AS SHOWN BY FINAL PROOF SURVEYS

PREPARED MAY 9, 1957